


T.2N. R.2&3W.W.M.

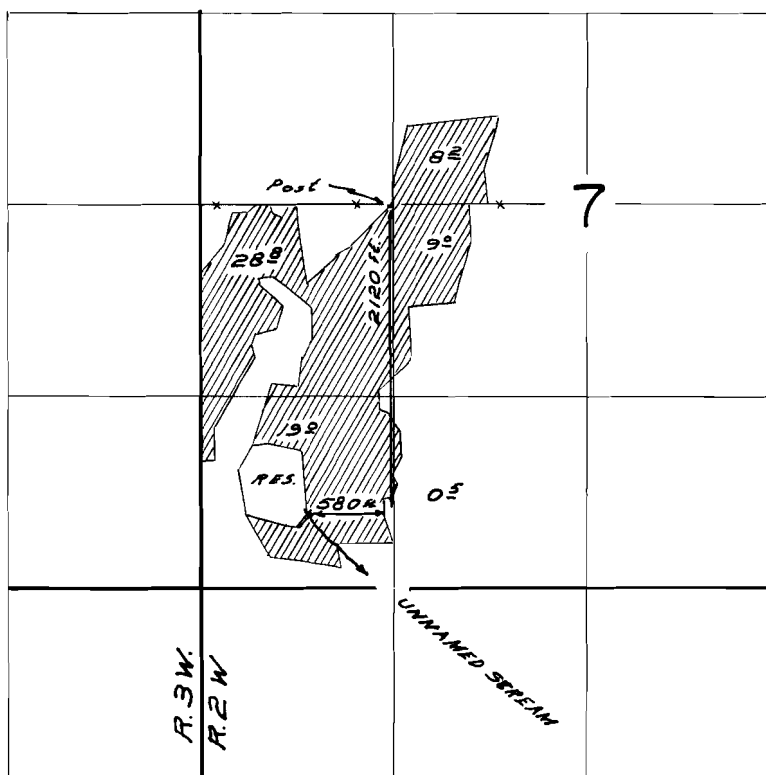


FINAL PROOF SURVEY
UNDER

Application No. R-38049 38050 Permit No. R-3217 28628
IN NAME OF

Henry B. Carlson

Surveyed Aug. 24 1966, by W.J. Ruppert

T.2 N.R.2&3 W.W.M. .

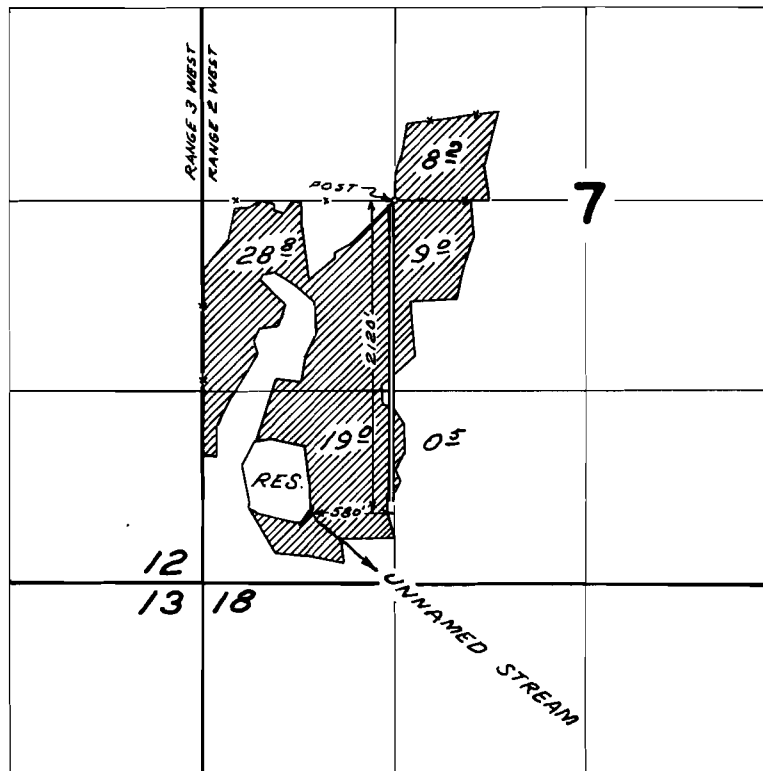

FINAL PROOF SURVEY
UNDER

Application No. R-38049 38050 Permit No. R-3217 28628
IN NAME OF

HENRY B. CARLSON

Surveyed AUG. 24 1966, by W. J. RUPPERT