


# T.1N.R.3W.W.M.

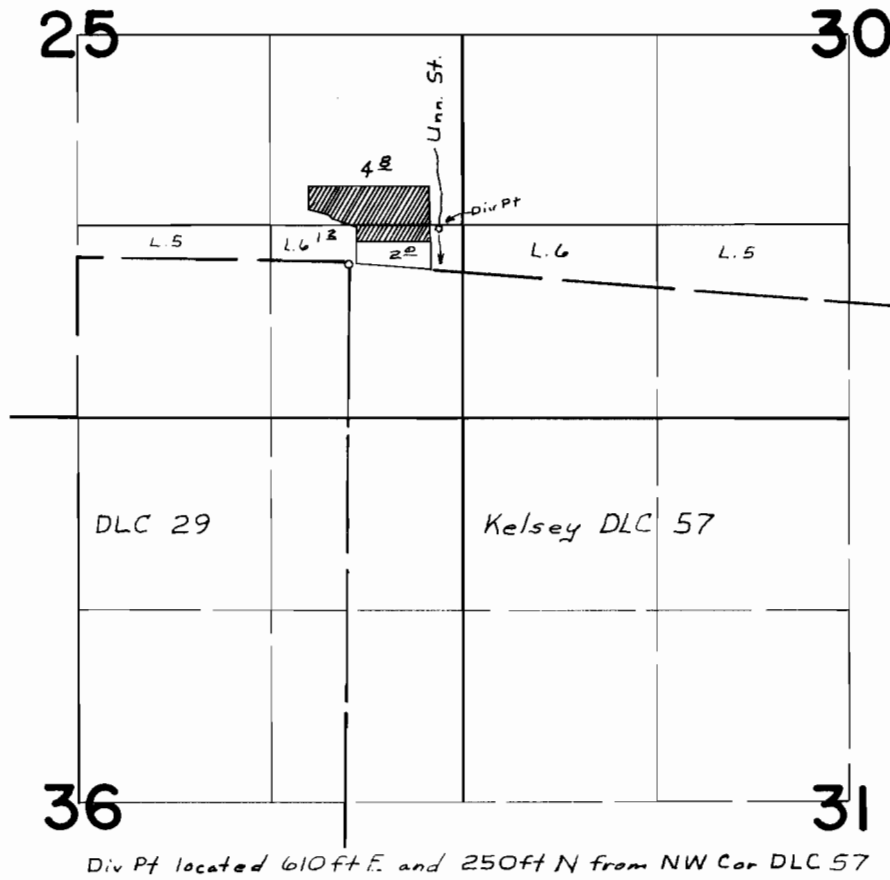

## FINAL PROOF SURVEY UNDER

Application No. 41084 Permit No. 30437  
IN NAME OF

..... Norbert H. Buehl .....

Surveyed Aug 17 1967, by W.J. Ruppert.