


# T.I.N. & I.S.R. 4 W. W.M.

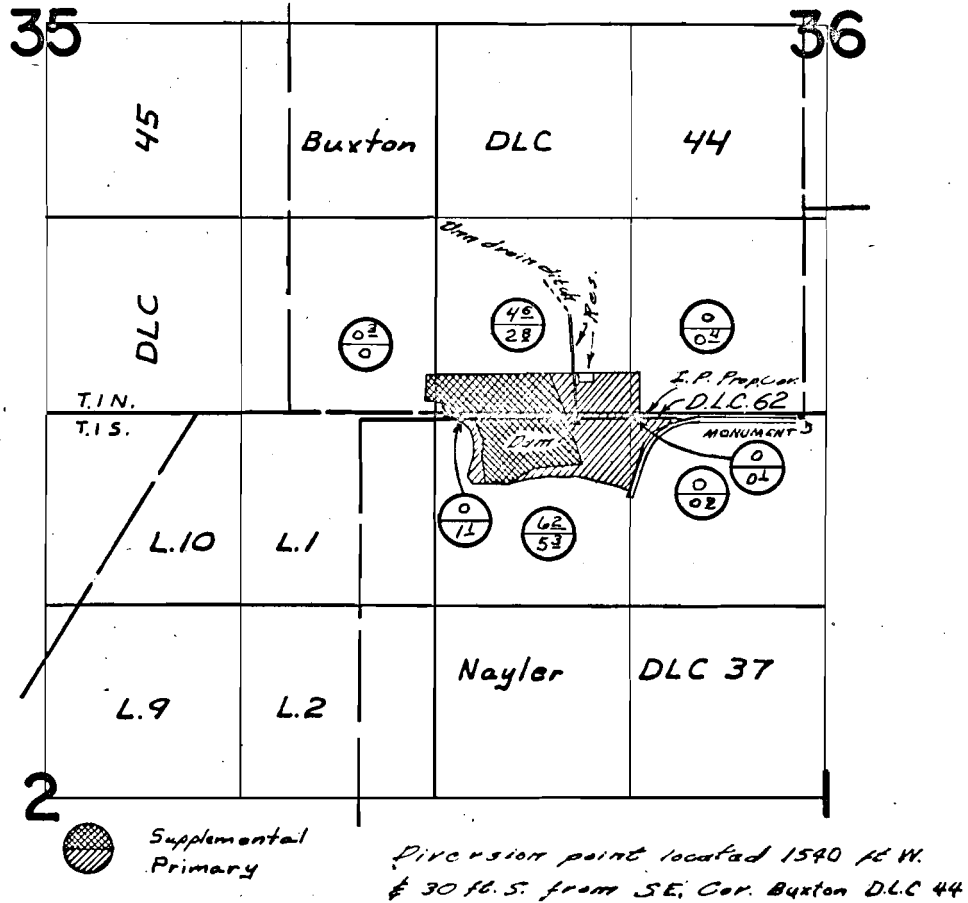

## FINAL PROOF SURVEY UNDER

Application No. *R-41003* *R-4599* Permit No. *41004* *30572*...  
IN NAME OF

*Francis Duysk*

Surveyed *Aug. 18*.... 19*67*., by *W. J. Ruppert*...