


T.2N.R.3W.W.M.

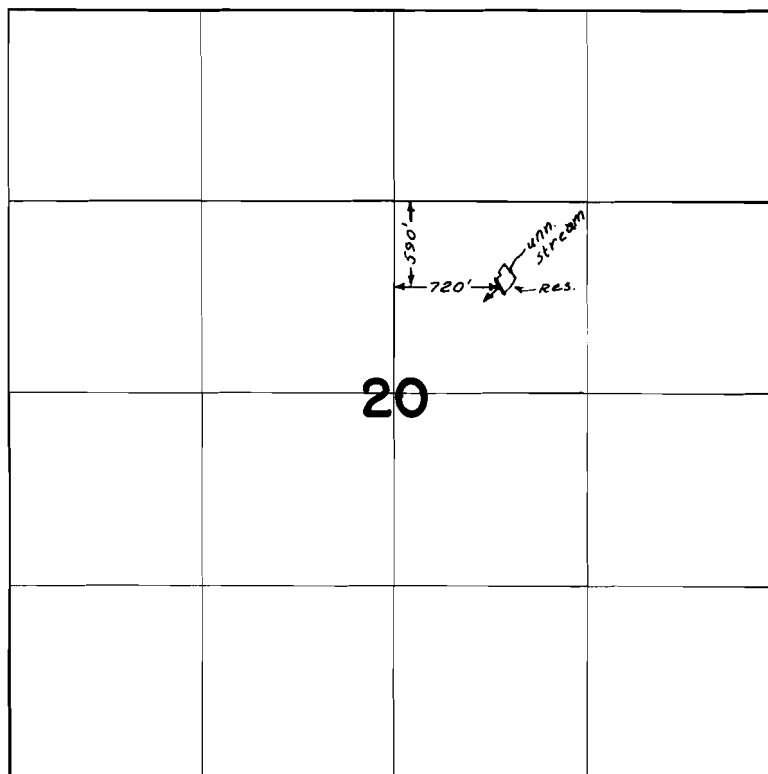

FINAL PROOF SURVEY
UNDER

Application No. R-41085 Permit No. R-4602
41086 IN NAME OF

Richard B. Gatke & Leslie A. Wilson

Surveyed Aug. 14, 1967, by W.J. Ruppert