


# T. 5 S. R. 3 & 4 W. W. M.

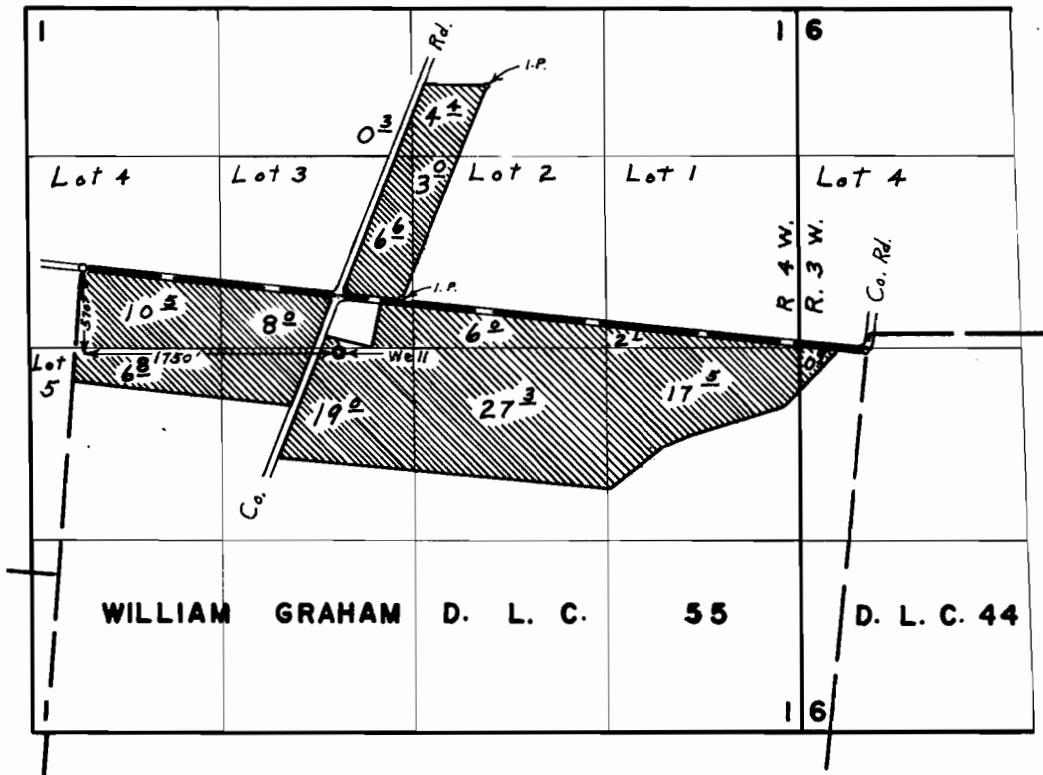

## FINAL PROOF SURVEY UNDER

Application No. G-2626 Permit No. G-2433  
IN NAME OF  
**WILLIAM E. STOCKHOFF**

Surveyed April 19, 1967, by L. E. Gould.