


T.5 S.R.6 W.W.M.

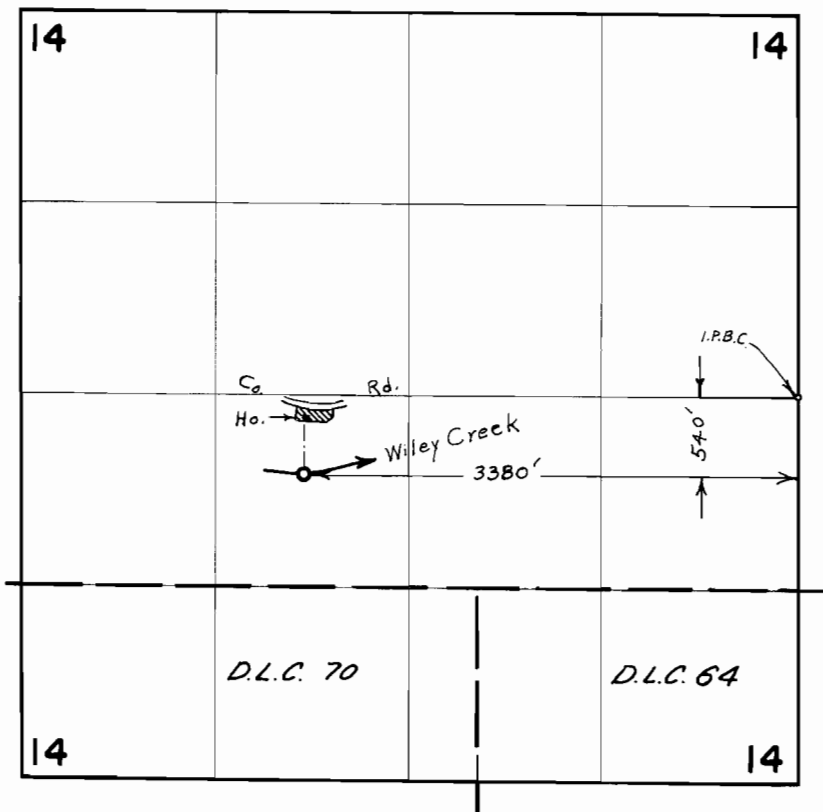

FINAL PROOF SURVEY
UNDER

Application No. 41318 Permit No. 30853
IN NAME OF
CHARLES L. SNOW

Surveyed July 7, 1967, by L. E. Gould