


# T.5 S.R.3 W.W.M.

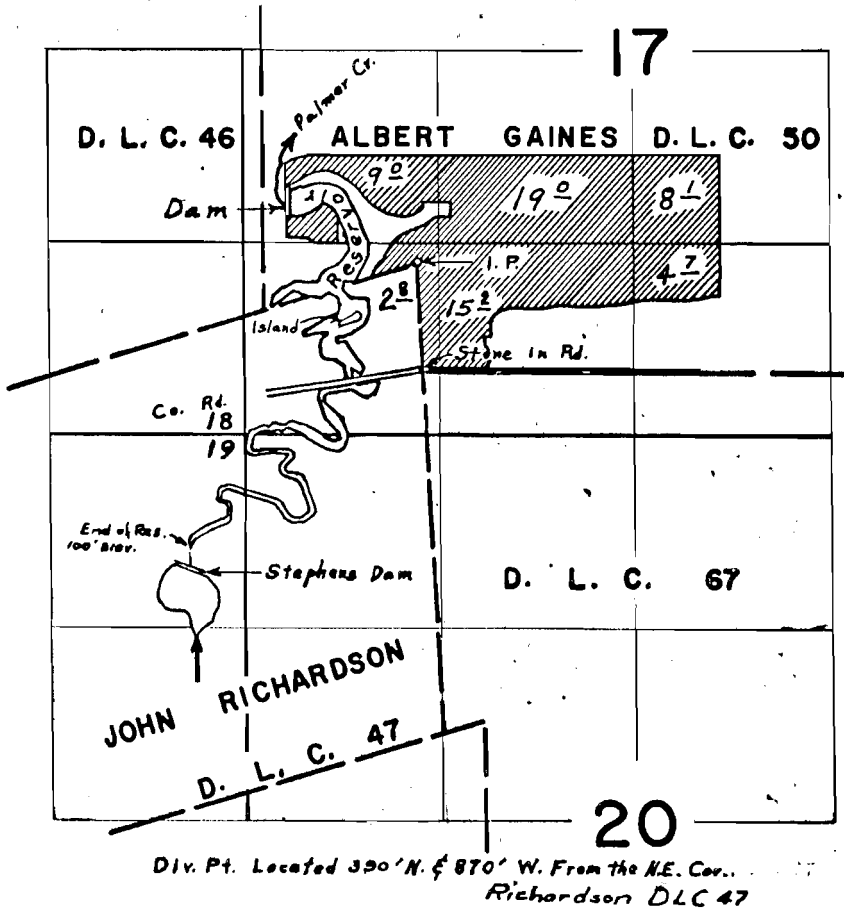

Div. Pt. Located 390' N. & 870' W. From the NE. Cor. of Richardson DLC 47

## FINAL PROOF SURVEY

UNDER

R-45955                      R-5466  
 45956                      34327  
 R-41619                      R-4683

Application No. 41620 Permit No. 31035

IN NAME OF

**X. J. & IDA M. DAUENHAUER**

Surveyed April 12, 1967, by L.E. Gauld...  
 Nov. 9, 1972 D. NORBY