


T. 4 N. R. 8 W. W. M.

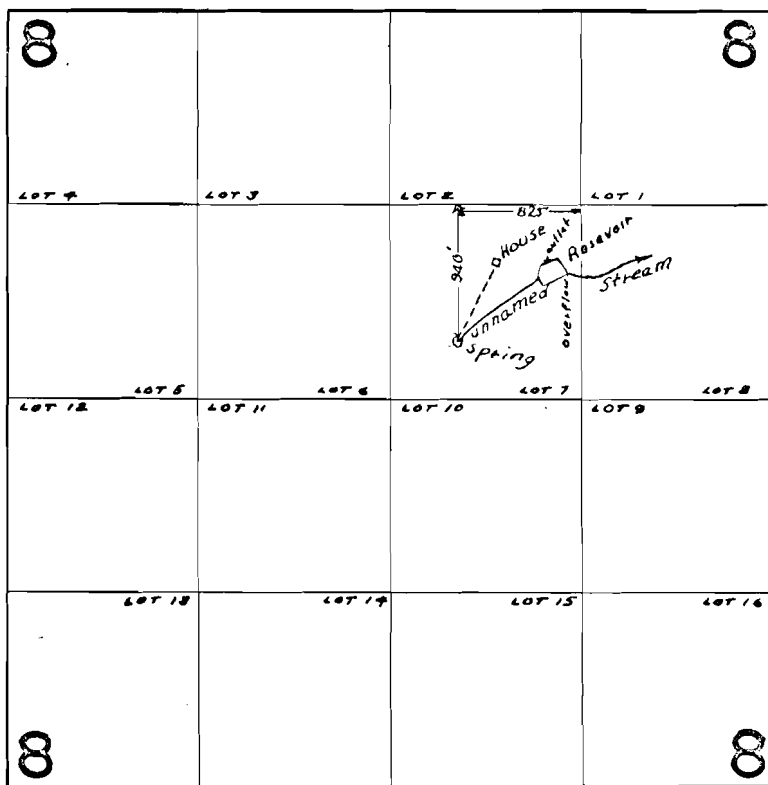

FINAL PROOF SURVEY
UNDER

Application No. R-42388 Permit No. R-4821
39573 29611
IN NAME OF

LYNN A. BRIGHAM

Surveyed June 20, 1966, by C. J. Gardner.....