


T.5N.R.8W. W.M.

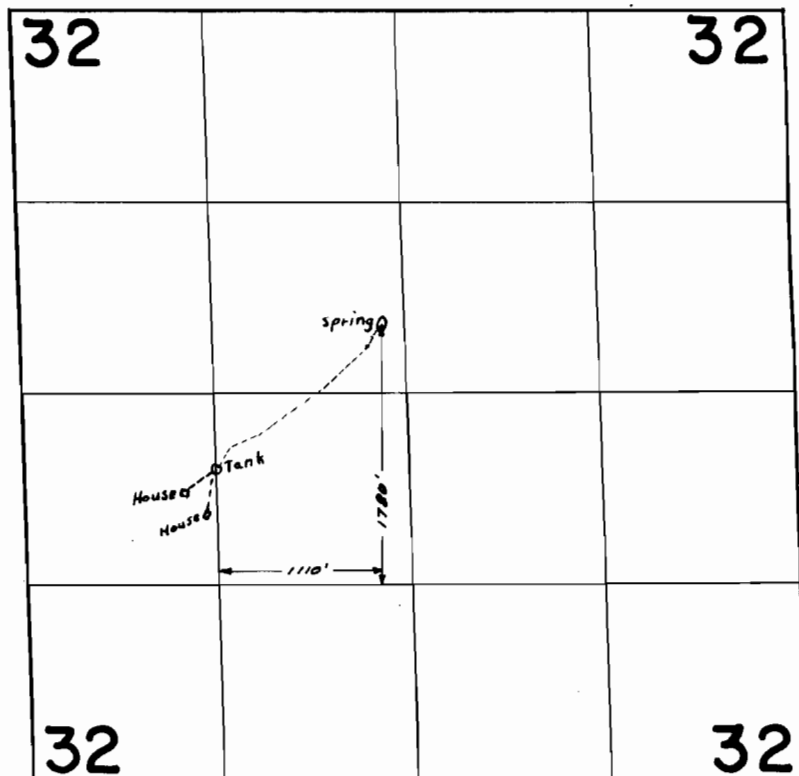

FINAL PROOF SURVEY
UNDER

Application No. 41039 Permit No. 30590
IN NAME OF

R. J. WALTON

Surveyed June 20, 1966, by C. J. Gardner