


T. 4 & 5 N. R. 4 W. W.M.

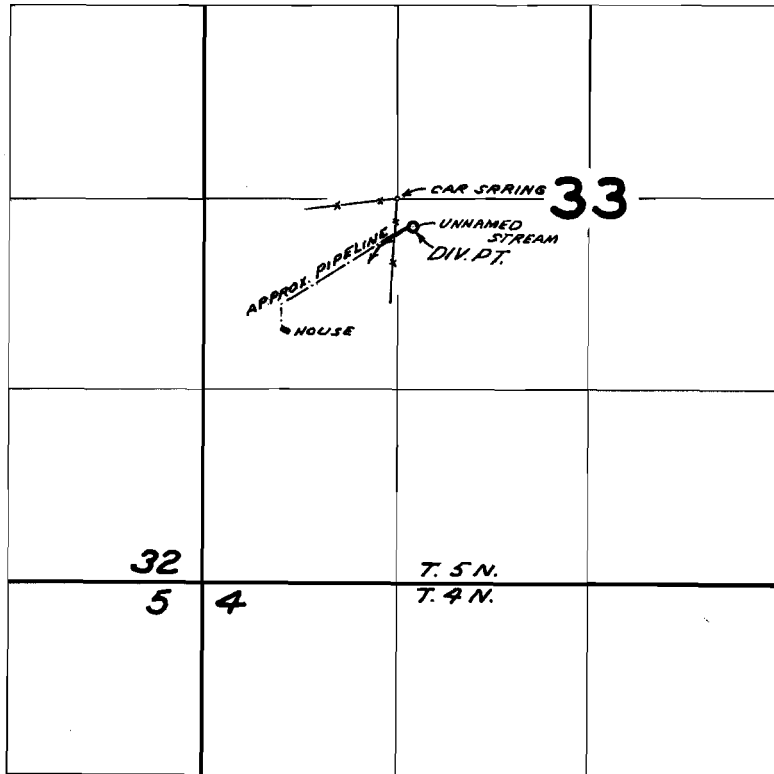

DIV. PT. LOCATED 130' S. & 100' E. FROM NE COR. NW 1/4 SW 1/4

FINAL PROOF SURVEY UNDER

Application No. 40341 Permit No. 30081
IN NAME OF
CLIFF NORWOOD

Surveyed JUL 20 1967, by V. GARNER