


T.28 S.R.11 W.W.M.

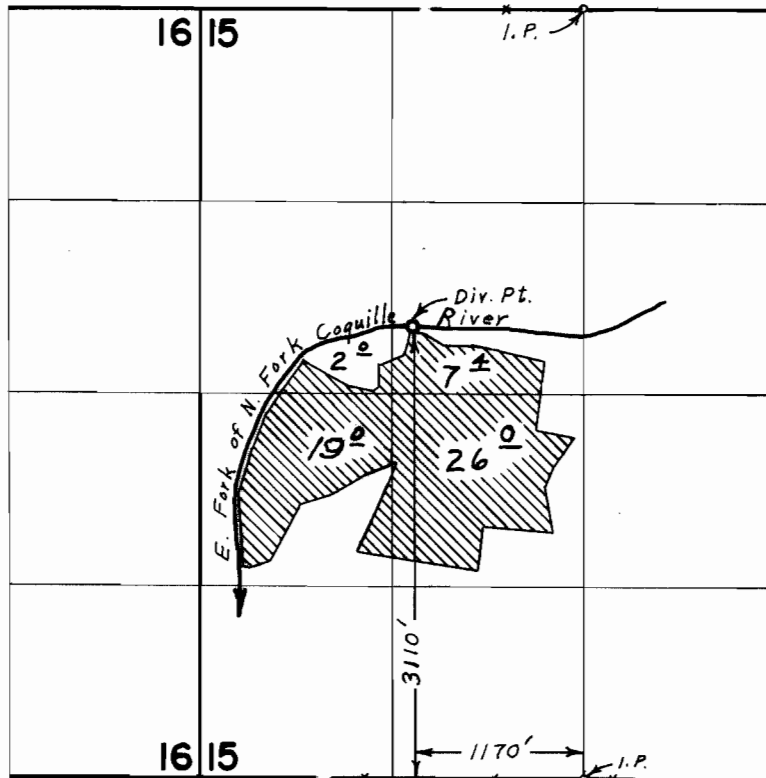

FINAL PROOF SURVEY UNDER

Application No. 39342 Permit No. 29289
IN NAME OF

CHARLES F. McGEORGE

Surveyed May 19, 1967, by L. E. Gould