


T. 25 S. R. 4W. W. M.

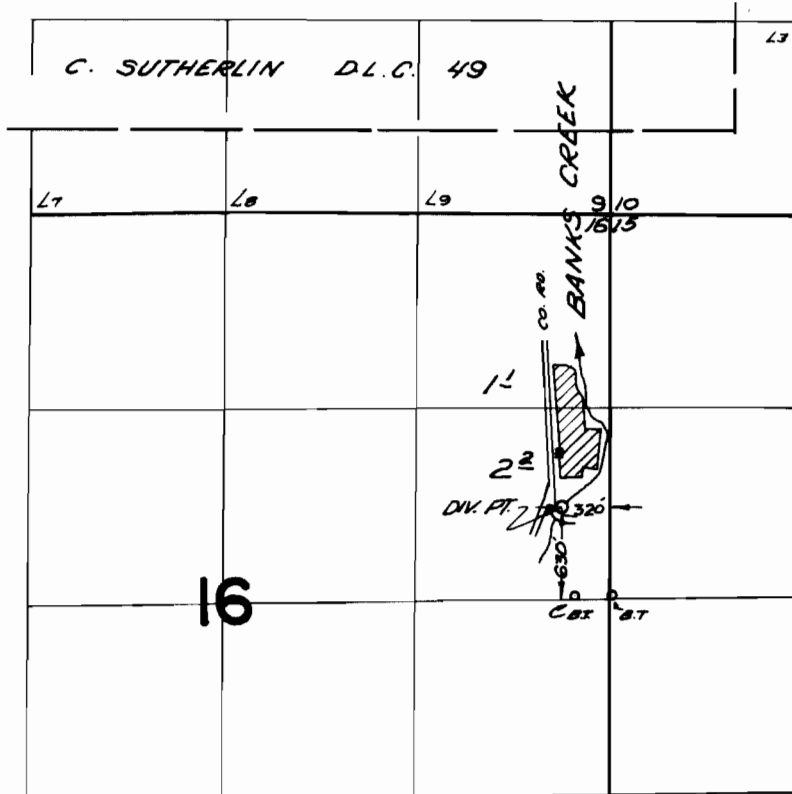

FINAL PROOF SURVEY UNDER

Application No. 39098 Permit No. 29105
IN NAME OF

A. I. and EDITH A. MARTINEAU

Surveyed June 18, 1967, by L. E. GRUBB