


# T. 25 S. R. 4W. W. M.

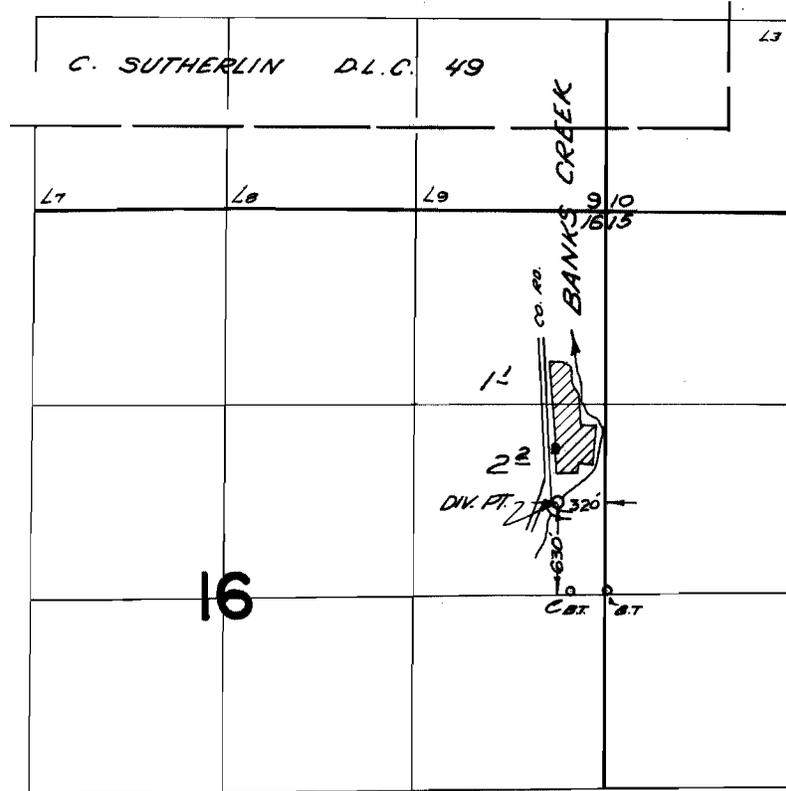

## FINAL PROOF SURVEY UNDER

Application No. 39098... Permit No. 29105...  
IN NAME OF

*A. I. and EDITH A. MARTINEAU*

Surveyed June 16, 1967, by L.E. Gould