
T.27S. R.6W. W.M.

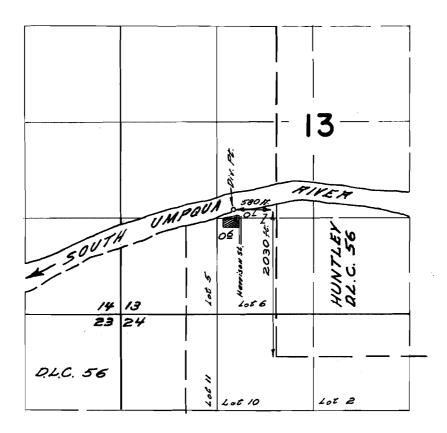

FINAL PROOF SURVEY

Application No. 40/47. Permit No. 29926 IN NAME OF

DELMAR D HOCKERSMITH

Surveyed May 12 1967, by W.d. Ruppert