


# T.38 S. R. 4 W. W.M.

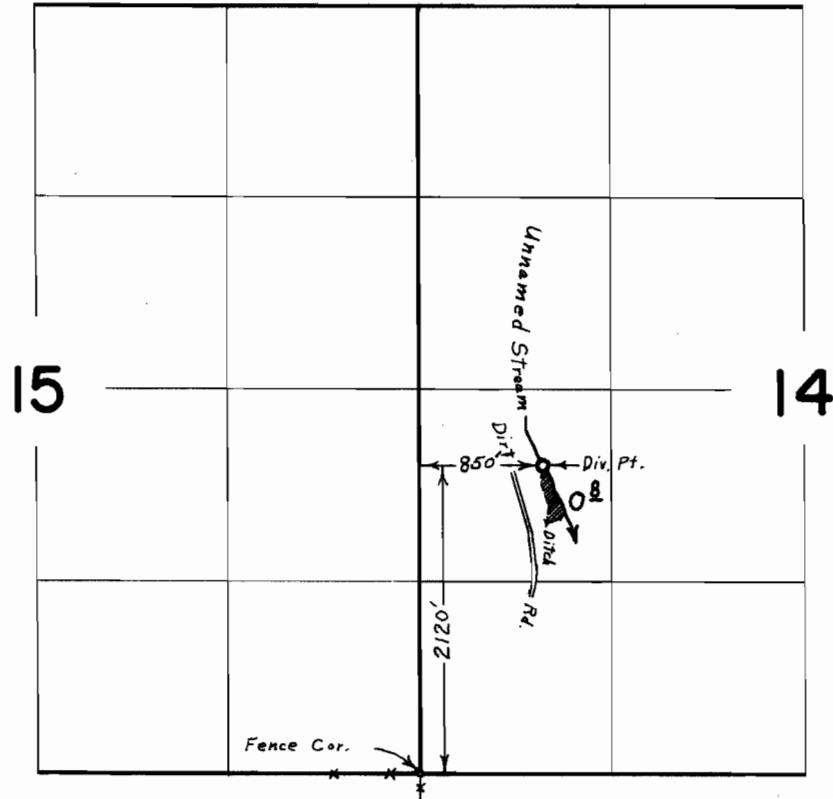

## FINAL PROOF SURVEY UNDER

Application No. 39080 Permit No. 29097  
IN NAME OF

**LEO C. DAVIS**

Surveyed July 29 1967, by L. E. Gould