


# T. 34 S. R. 4 W. W. M.

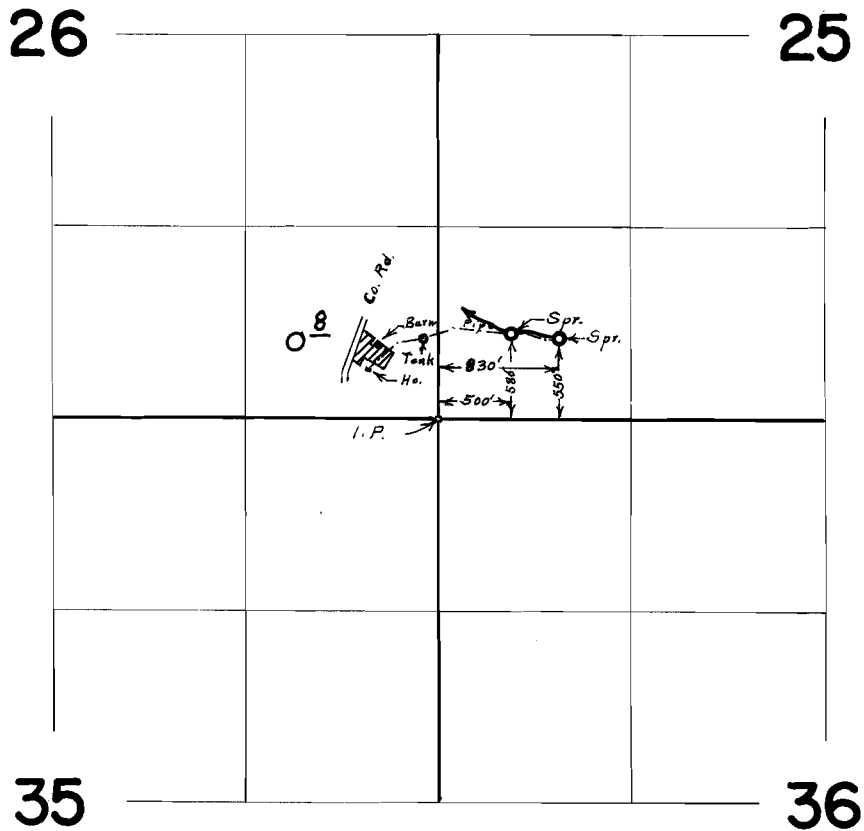

## FINAL PROOF SURVEY UNDER

Application No. 40143 Permit No. 29924  
IN NAME OF

E. L. BENNETT

Surveyed May 21, 1968, by L. E. Gould