
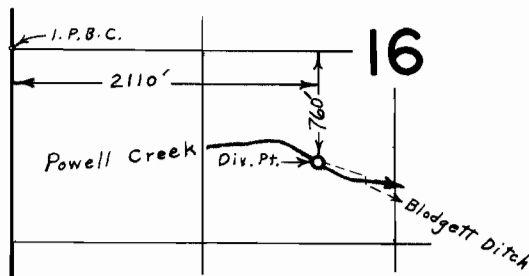


T.38S.R.5 W.W.M.

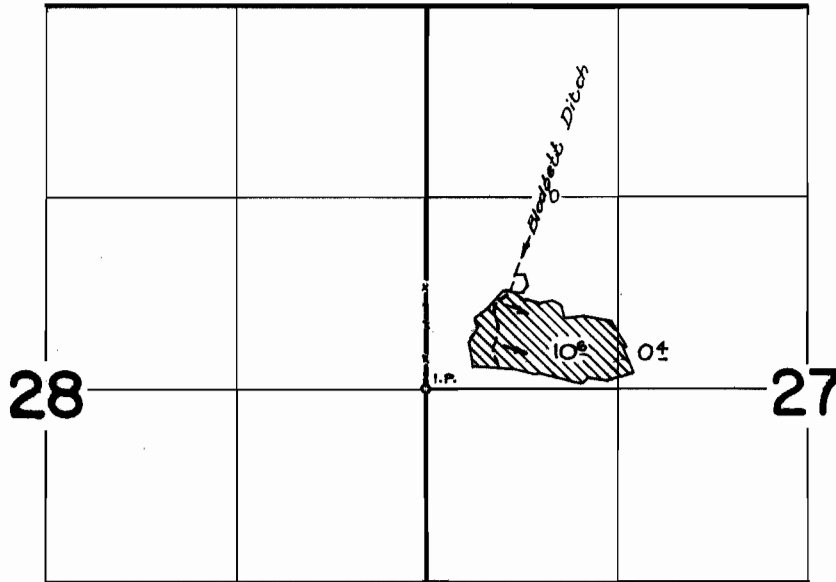

FINAL PROOF SURVEY
UNDER

Application No. 37390... Permit No. 27831.....
IN NAME OF

.....AZEL & J.CLEM. BLODGETT.....

Surveyed June 25, 1965, by *L. E. Gould*
(Div. Pt.) Aug. 22, 1967, by L.E. Gould