


T. 36 S. R. 5 W. W. M.

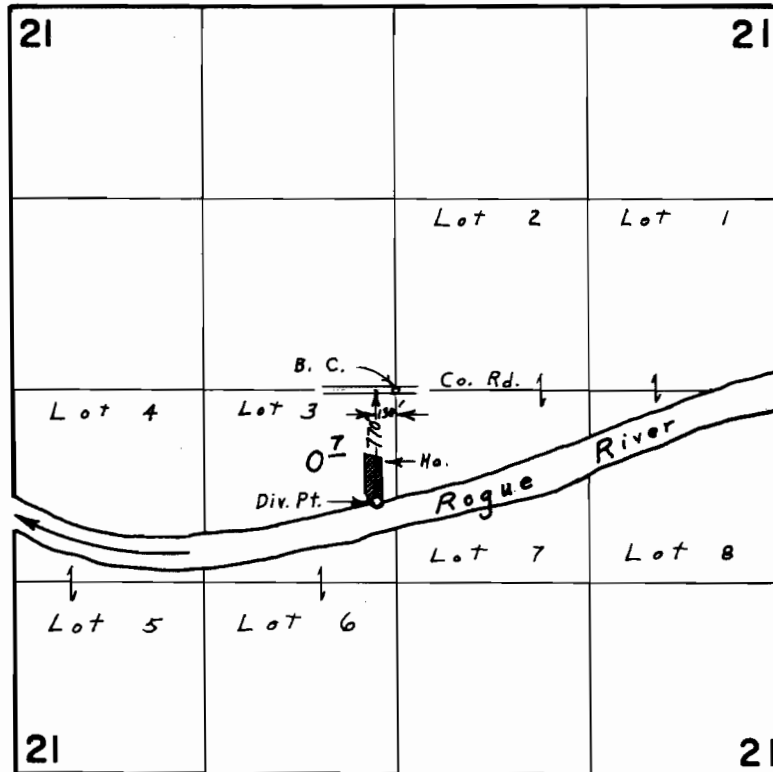

**FINAL PROOF SURVEY**  
UNDER

Application No. 42593 Permit No. 31823  
IN NAME OF

**RALPH R. HEITSTUMAN**

Surveyed Aug. 24 1967. by L. E. Gould