


T.36 S.R.5 W.W.M.

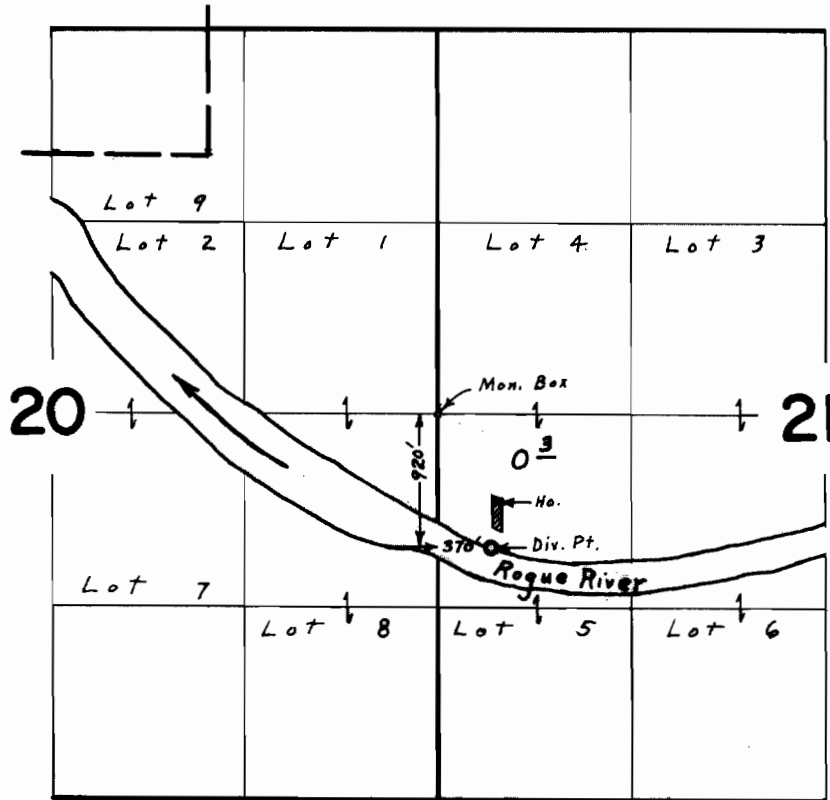

**FINAL PROOF SURVEY**  
UNDER

Application No. 42721 Permit No. 31919  
IN NAME OF

**EARNESTINE CHANEY**

Surveyed Aug. 24, 1967, by L. E. Gould