


T. 36 S. R. 7 W. W. M.

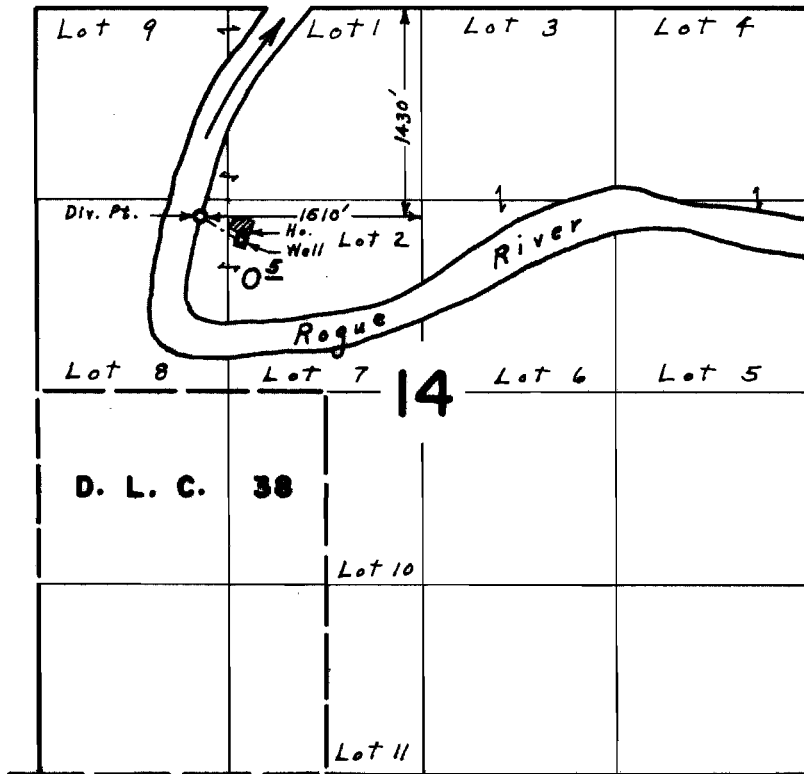

FINAL PROOF SURVEY
UNDER

Application No. 42765 Permit No. 31977
IN NAME OF
MERTON L. ROOT

Surveyed Aug. 30, 1967, by L. E. Gould