




G-2065

35644  
T9813  
814 82

# T.26S.R.15E.W.M.

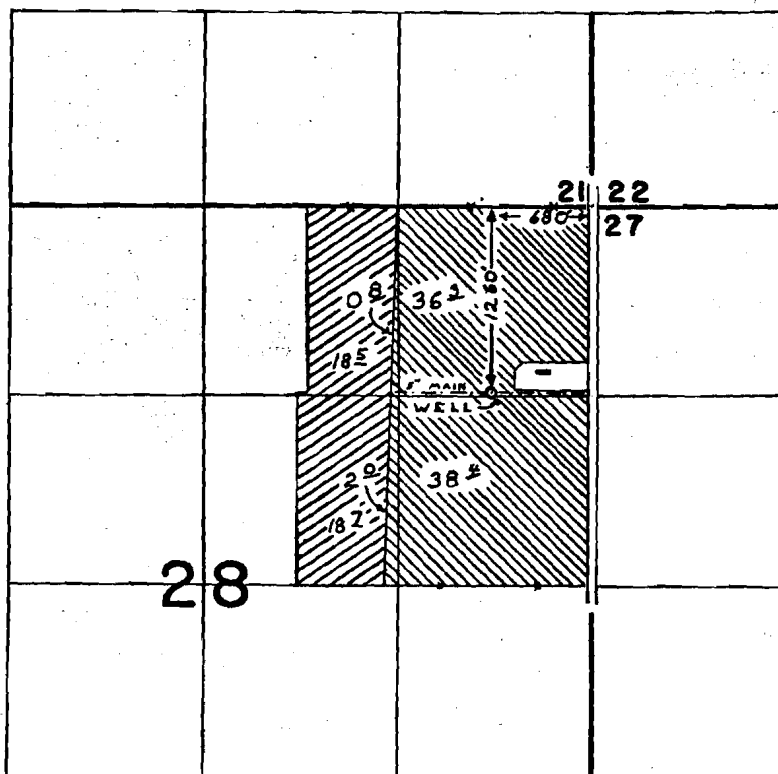

-  PERMIT G-2065
-  PERMIT G-6522

## FINAL PROOF SURVEY UNDER

G-7034                      G-6522  
 Application No. 3-2243    Permit No. G-2065  
 IN NAME OF

MAURICE L. WARD

Surveyed AUG. 6, 1968, by L. E. GOULD  
 JUL 16, 1977                      D. M. NORBY