


# T. 20 S. R. 3 W. W.M.

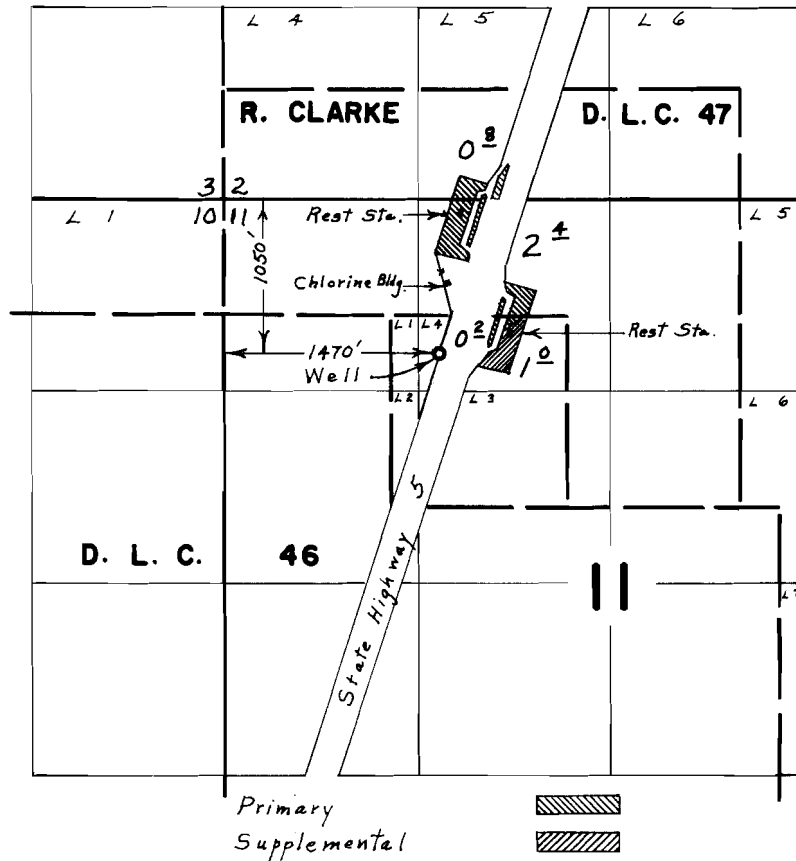

## FINAL PROOF SURVEY UNDER

Application No. G-2914 Permit No. G-2708  
IN NAME OF  
**OREGON STATE HIGHWAY COMMISSION**

Surveyed Sept. 19, 1967. by L. E. Gould.