




# T.20&21S.R.3W.W.M.

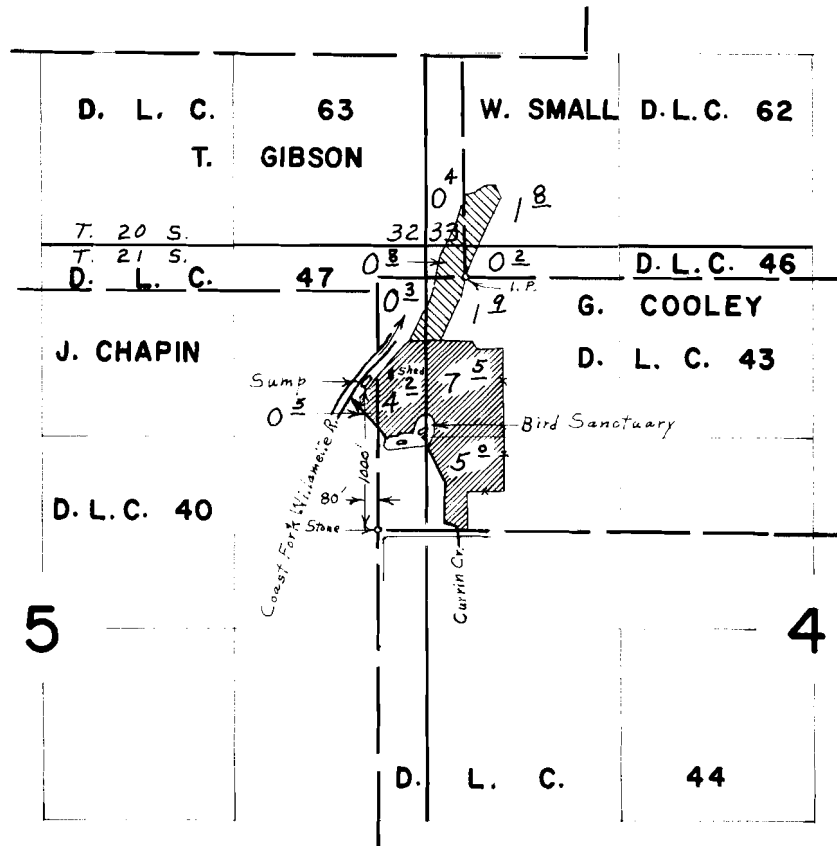

## FINAL PROOF SURVEY UNDER

Application No. **G-3097** Permit No. **G-2892**   
**G-3261** Permit No. **G-3059** 

IN NAME OF

**WALTER A. WOODARD**

Surveyed *Sept. 21 19* , by *L. E. Gould*