


T.16S.R.4W.W.M.

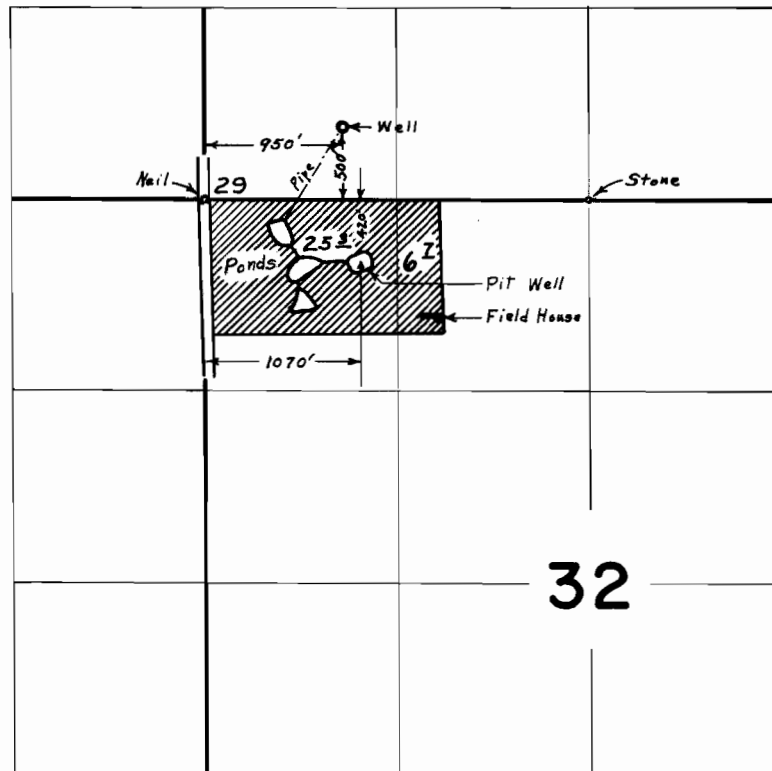

FINAL PROOF SURVEY
UNDER

Application No. G-3306 Permit No. G-3079
IN NAME OF
BEN & VIRGINIA SIMPSON

Surveyed April 26, 1967, by L. E. Gould