


T. 20 S. R. 3 W. W. M.

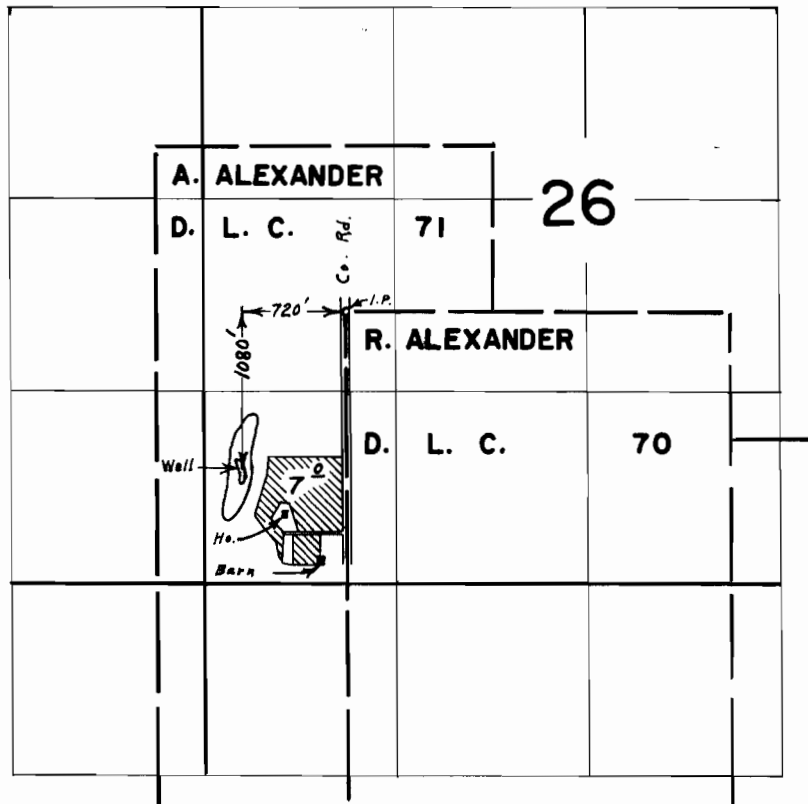

FINAL PROOF SURVEY
UNDER

Application No. G-3528 Permit No. G-3320
IN NAME OF

JOHN C. EDWARDS

Surveyed Sept. 21, 1967, by L. E. Gould