


T.15S.R.7W.W.M.

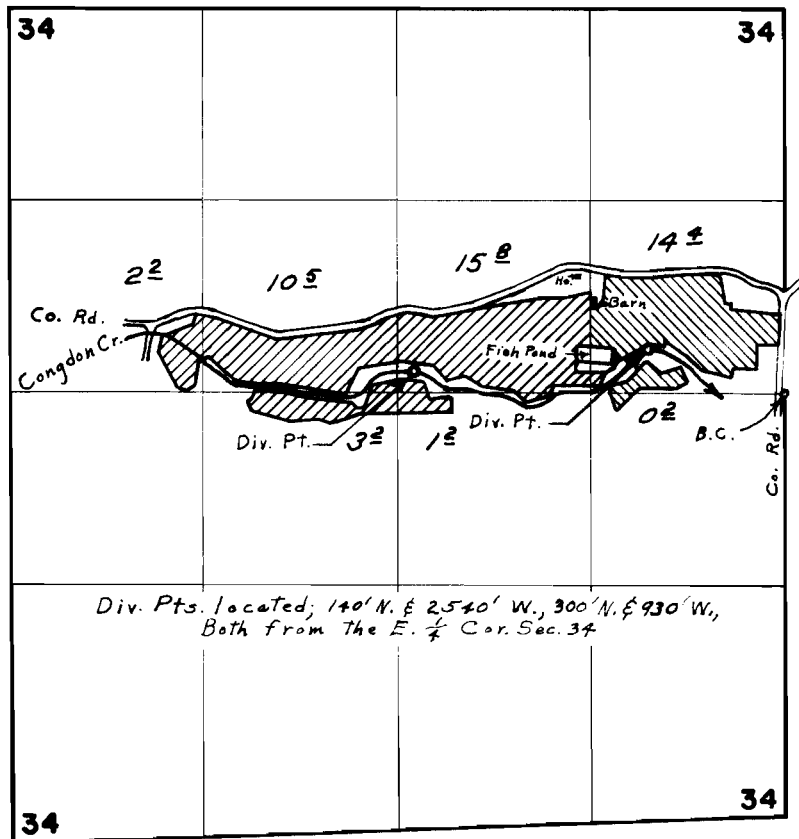

FINAL PROOF SURVEY
UNDER

Application No. 37477 Permit No. 27900
IN NAME OF
FELTON O. BARKER

Surveyed May 4, 1967, by L. E. Gould