


T.15S.R.5W.W.M.

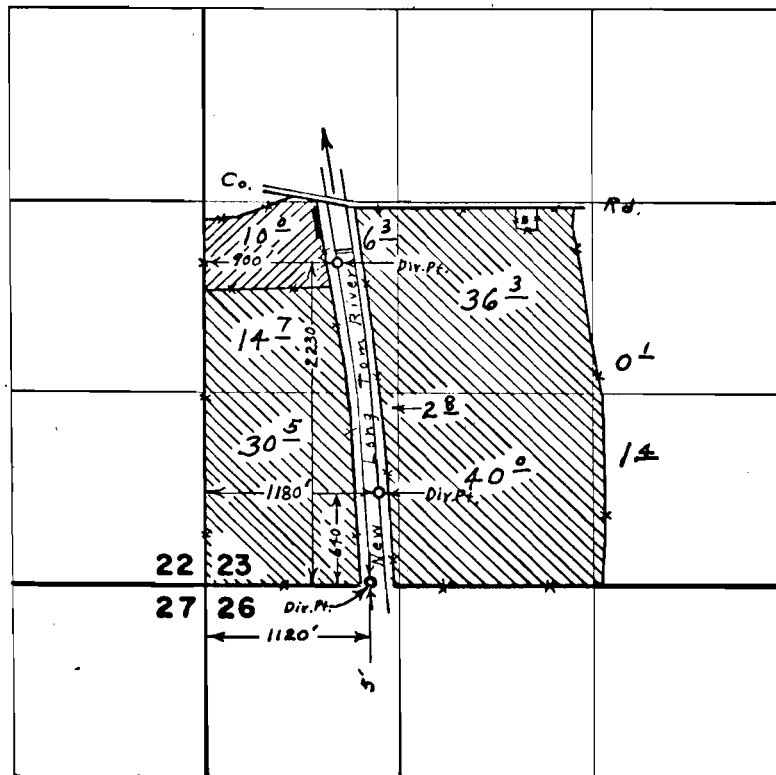

FINAL PROOF SURVEY
UNDER

38480 28654
Application No. 38481 Permit No. 28655
IN NAME OF

HOWARD & GLADYS GIBSON

Surveyed May 2, 1967, by L. E. Gould