


T.16S.R.6W.W.M.

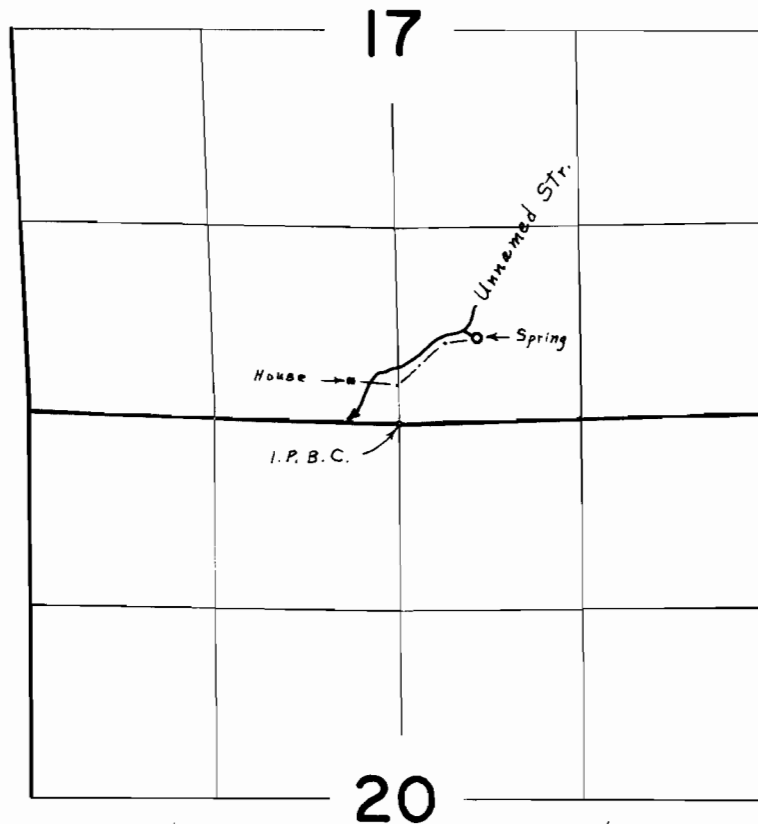

Spring located 590' N. & 530' E. from S. $\frac{1}{4}$ Cor. Sec. 17

FINAL PROOF SURVEY
UNDER

Application No. 38628... Permit No. 28756..

IN NAME OF

GERALD D. SYPHERS

Surveyed May 10, 1967, by L. E. Gould...