


T. 19 S. R. 3 W. W. M.

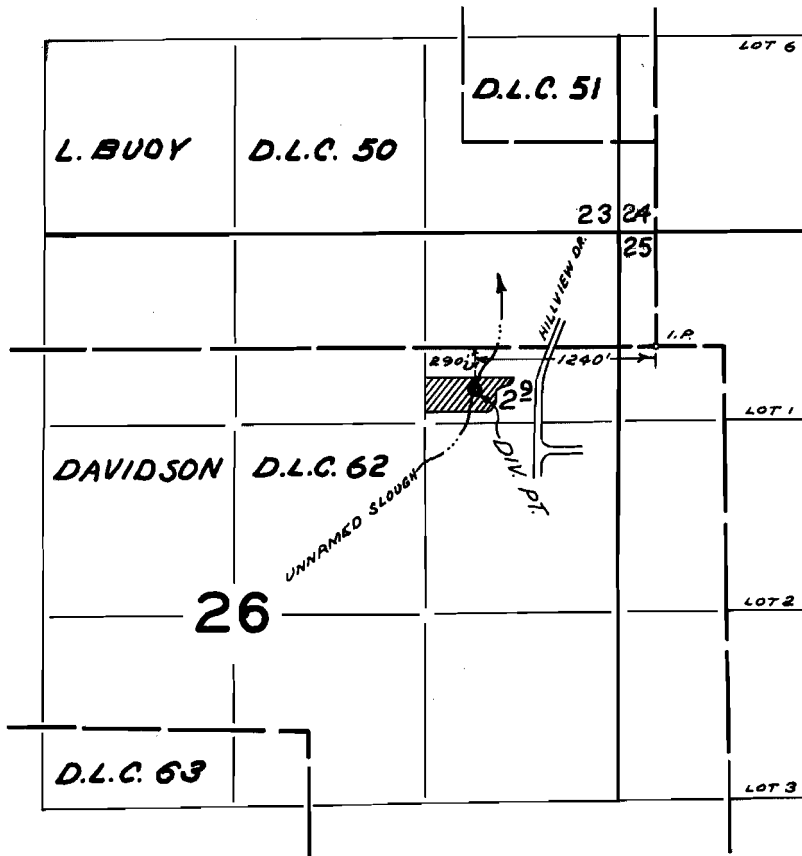

FINAL PROOF SURVEY
UNDER

Application No. 40194 Permit No. 29985
IN NAME OF

ELIAS DUTTON

Surveyed DEC. 1965, by C. GARDNER
INSR. MAY 3, 1966, By R. JACKSON