


T.15&16 S.R.6 W.W.M.

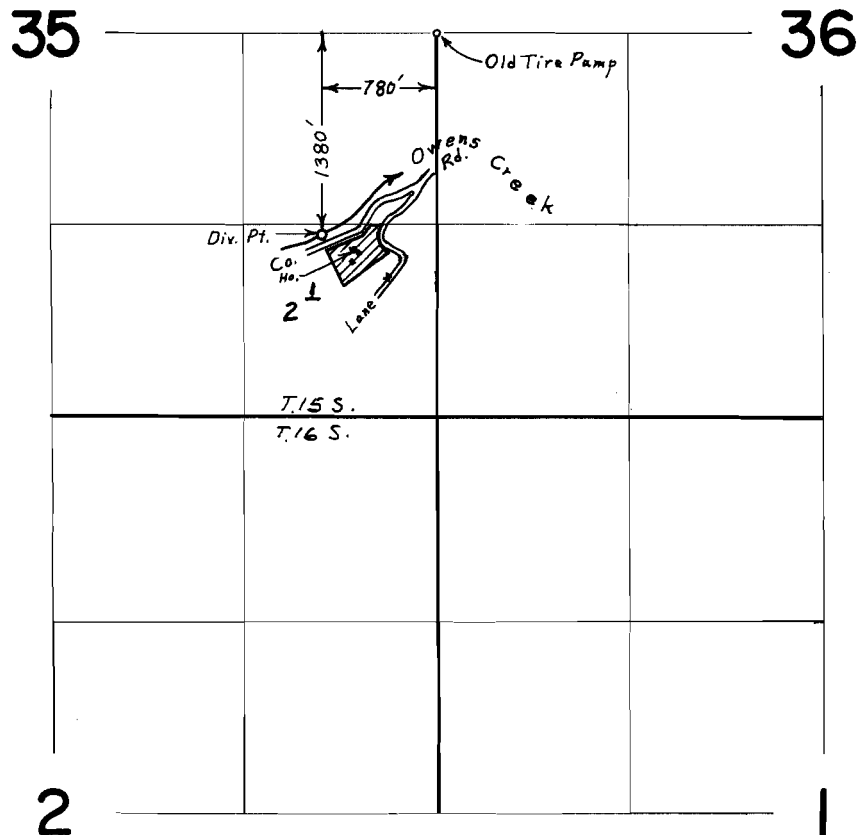

FINAL PROOF SURVEY
UNDER

Application No. 40372 Permit No. 30100
IN NAME OF

BURKE LANE & VIVA McFADDEN, JR.

Surveyed May 3 1967, by L. E. Gould