


# T. 20 S. R. 5 W. W. M.

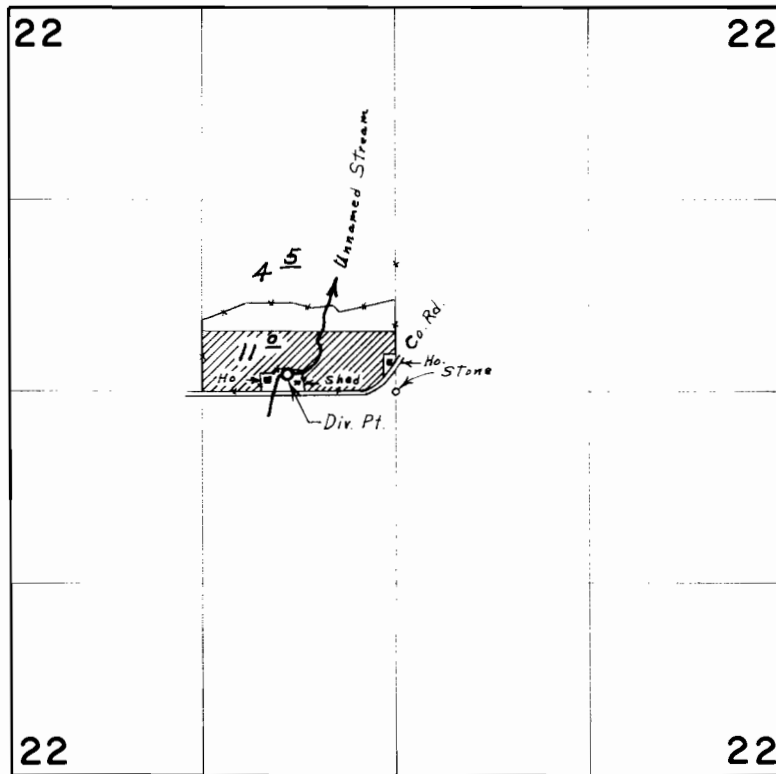

*Div. Pt. located 120' N. & 7.30' W. from Center Section 22*

## FINAL PROOF SURVEY UNDER

Application No. 41118 ... Permit No. 30655  
IN NAME OF  
**WALTER & VIOLET LOECK**

Surveyed Sept. 20, 1967, by L. E. Gould