


# T.20S.R.5W.W.M.

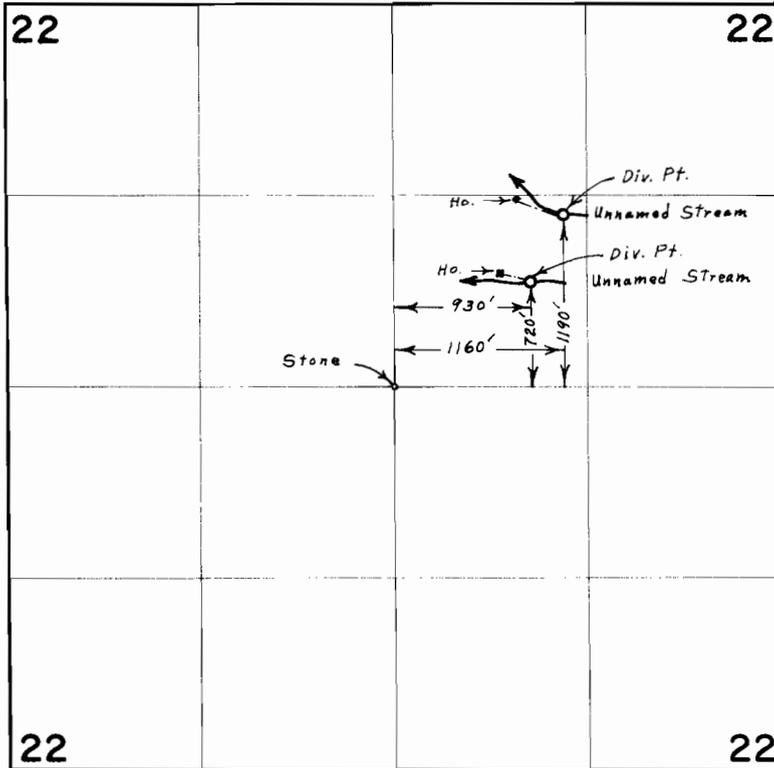

## FINAL PROOF SURVEY UNDER

Application No. 41838 Permit No. 31217  
IN NAME OF

ELMER & LA VERNE BRISLER

Surveyed Sept. 20, 1967, by L. E. Gould.