


T.16S.R.7W.W.M.

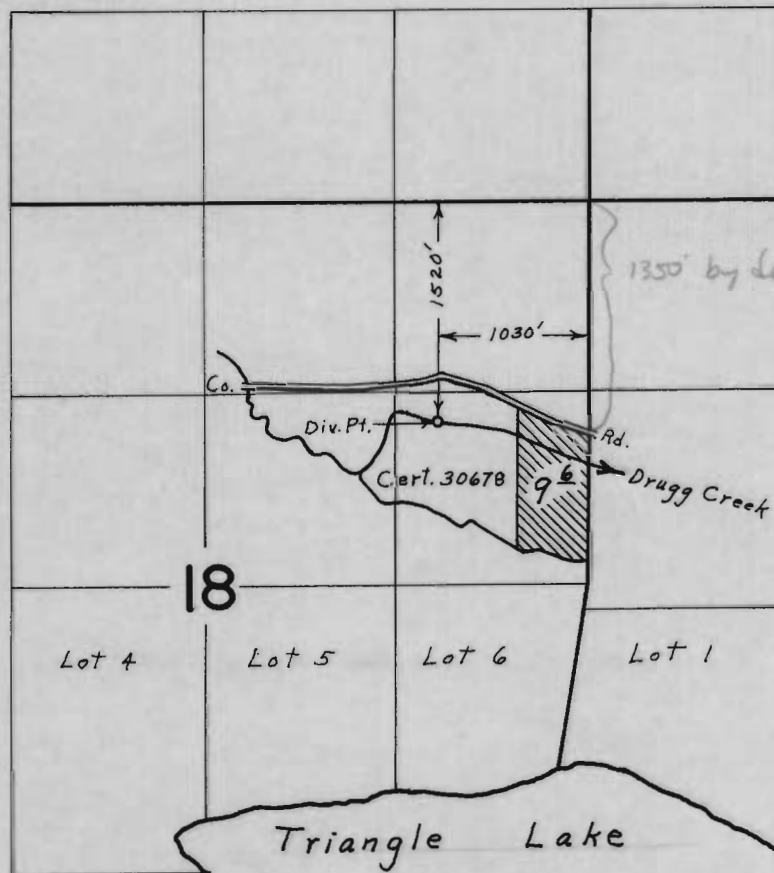

FINAL PROOF SURVEY
UNDER

Application No. 42437 Permit No. 31248
IN NAME OF

CHARLES R. TIPTON

Surveyed May 12, 1967, by L. E. Gould