


T. 7 S. R. 10 & 11 W. W. M.

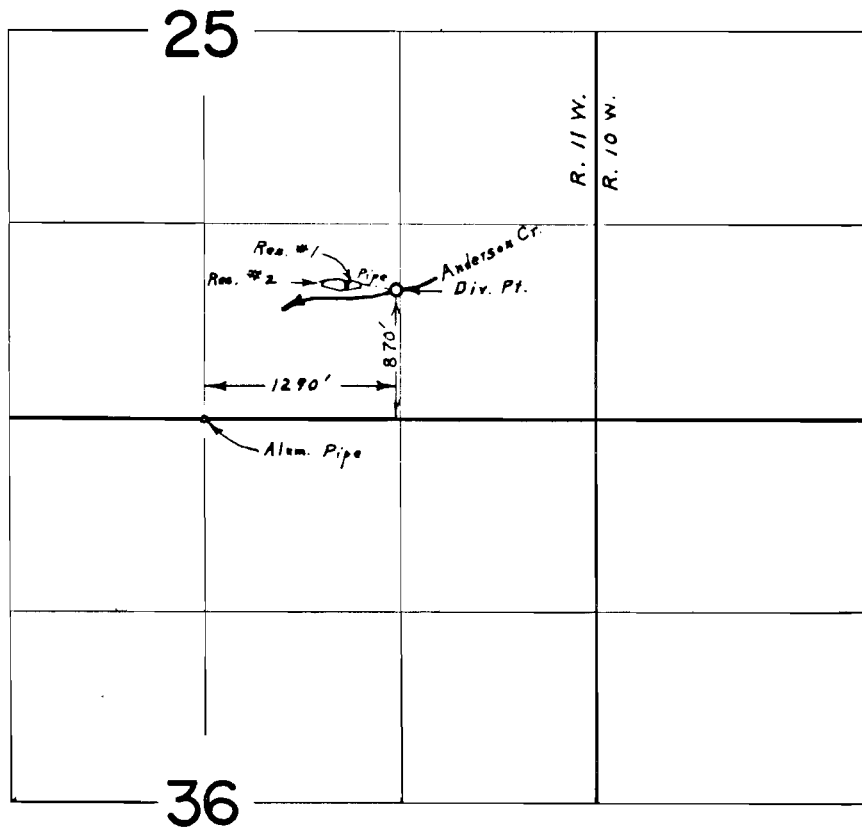

FINAL PROOF SURVEY UNDER

Application No. *R-37709* 37710 Permit No. *R-3083* 28183
IN NAME OF
E. E. STEWART

Surveyed *Aug. 17, 1967,* by *L. E. Gould*