


T. 7 S. R. 10 & 11 W. W. M.

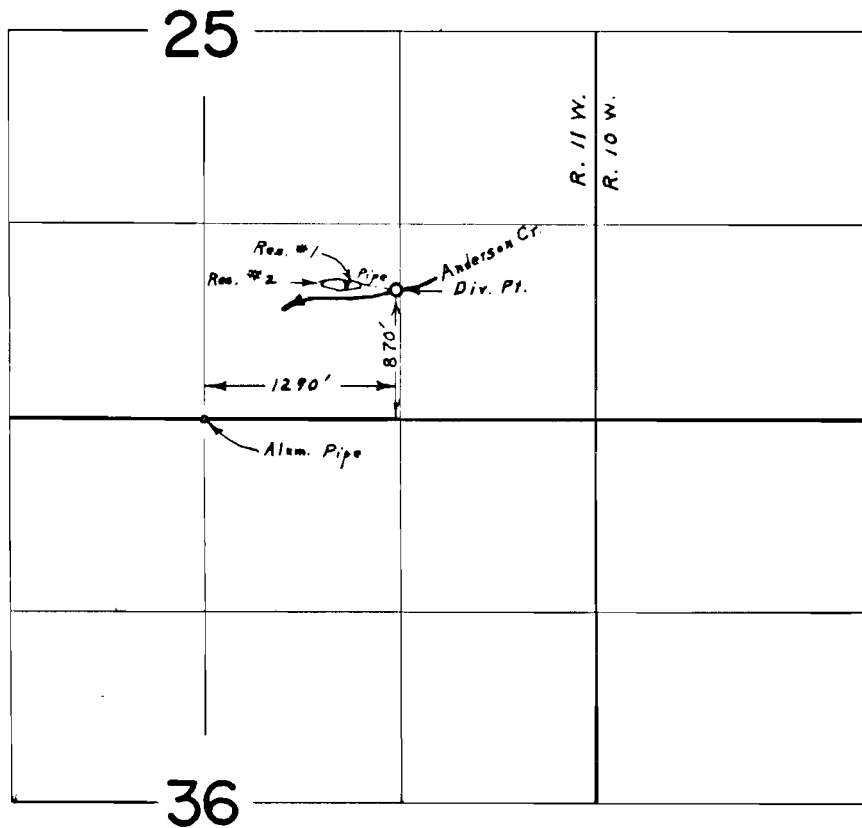

FINAL PROOF SURVEY UNDER

Application No. *R-37709* 37710 Permit No. *R-3083* 28183...
IN NAME OF

E. E. STEWART

Surveyed Aug. 17, 1967, by L. E. Gould...