


T. 6 S. R. 11 W. W. M.

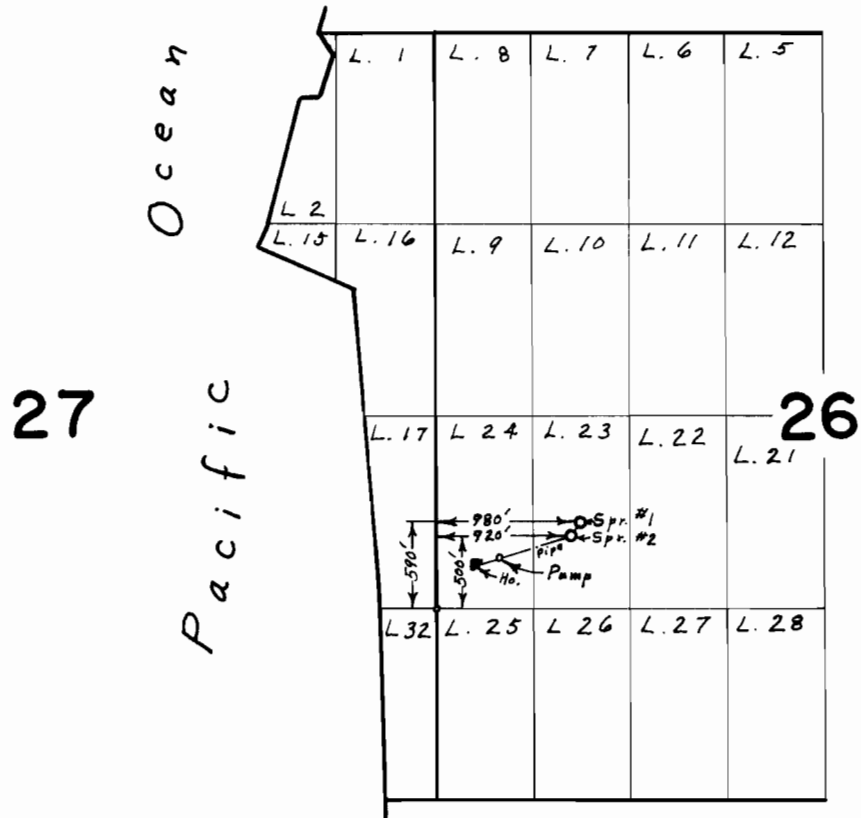

FINAL PROOF SURVEY UNDER

Application No. 38912 Permit No. 29029
IN NAME OF

ROBERT S. & MARTHA C. BELL

Surveyed Sept. 25, 1967, by L. E. Gould