


T. 8 & 9 S. R. 11 W. W. M.

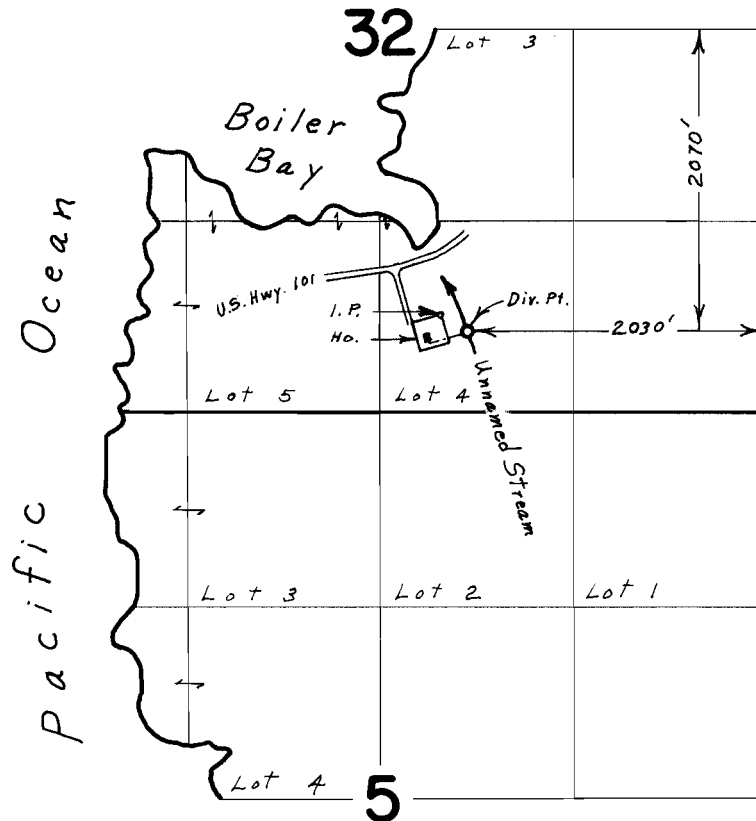

**FINAL PROOF SURVEY**  
UNDER

Application No. 40591 Permit No. 30240

IN NAME OF

G. KOREVAAR, JOHN J. BRADLEY,  
R. A. CHRISTIANSEN, WILLIAM WOOD, & BEN H. BRIGGS

Surveyed Sept 25, 1967, by L. E. Gould