


T. 6 S. R. 11 W. W. M.

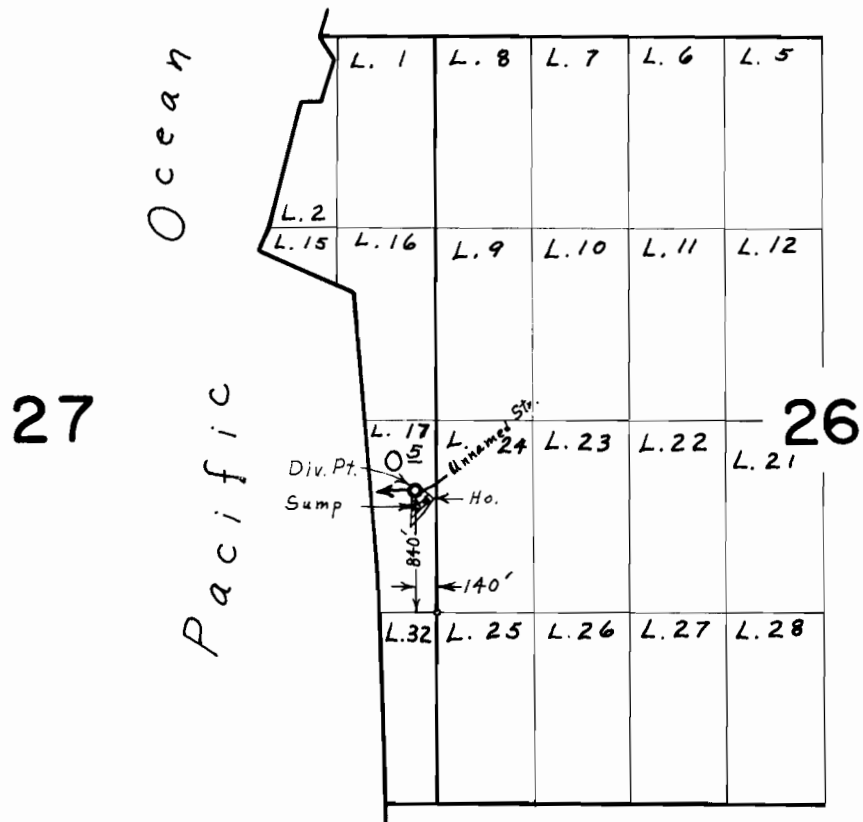

FINAL PROOF SURVEY UNDER

Application No. 41847 Permit No. 31316
IN NAME OF

STELLA A. GROTH

Surveyed Aug. 16, 1967, by L. E. Gould