


T. 4 S. R. 2 W. W.M.

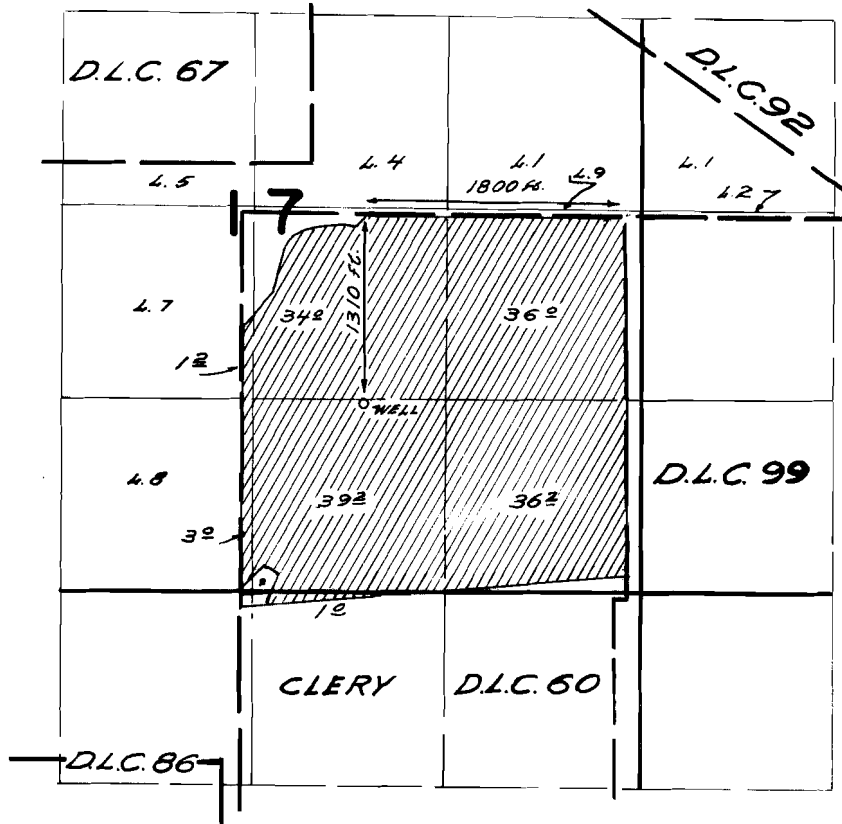

FINAL PROOF SURVEY
UNDER

Application No. G-3024 Permit No. G-2813
IN NAME OF

WALTER J WILMES

Surveyed May 2, 1967, by W.J. Ruppert