


T. 4 S. R. 2 W. W.M.

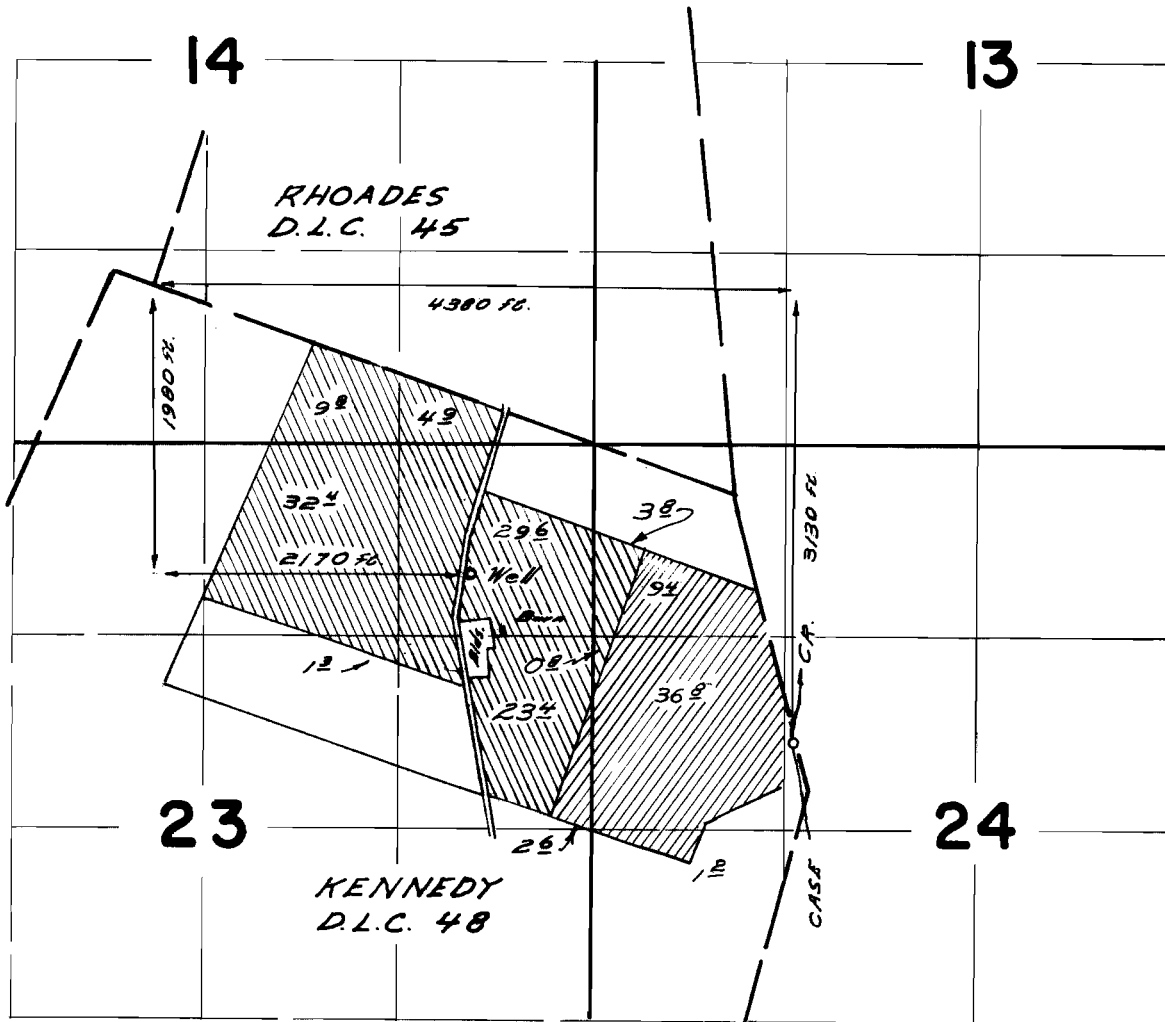

FINAL PROOF SURVEY
UNDER

ALL ACREAGE UNDER PERMIT No. G-2841



Application No. G-3045 / 3916.7 Permit No. G-2841 / 29216
IN NAME OF

UNDER PERMIT No. 29216 &
SUPPLEMENTAL TO
G-2841

EDWARD D. GRASSMAN

Surveyed April 7, 1967, by W.T. Ruppert.