


T.6 S. R.3 W. W.M.

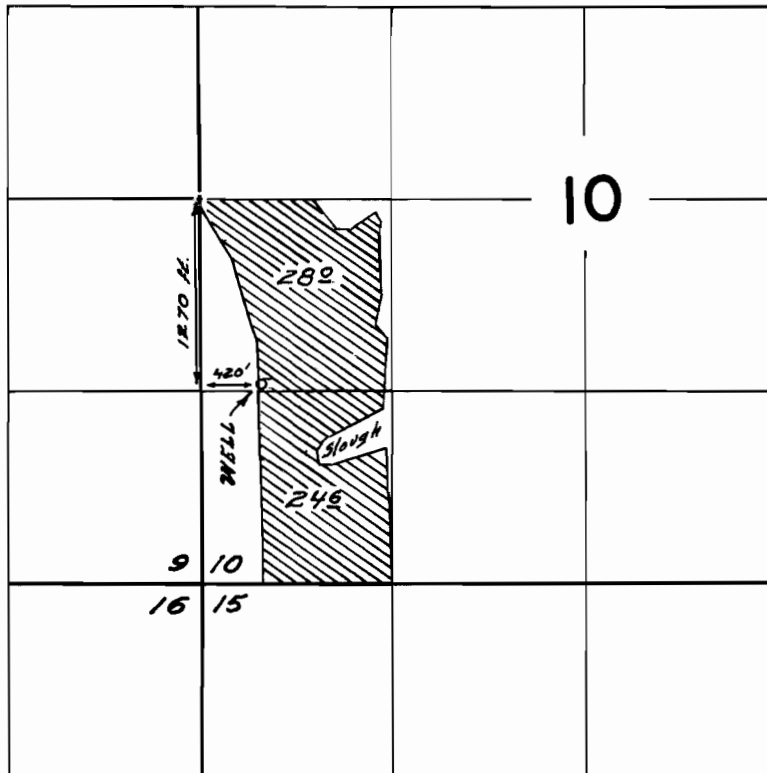

**FINAL PROOF SURVEY**  
UNDER

Application No. *G-3413* Permit No. *G-3201*  
IN NAME OF

*KENNETH R. JOHNSON*

Surveyed *Nov. 20, 1967*, by *W. J. Ruppert*