


# T.9S.R.3W.W.M.

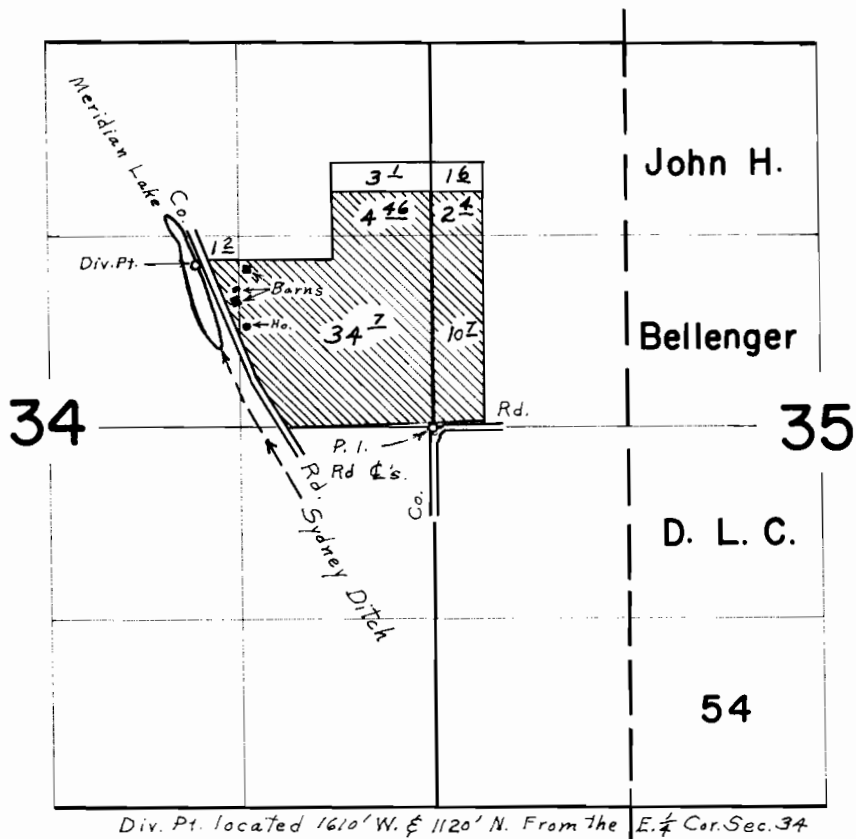

## FINAL PROOF SURVEY UNDER

Application No. 37405 Permit No. 27860  
IN NAME OF  
**LOUIS E. FRICK**

Surveyed April 4, 1967, by L. E. Gould