


T.7S.R.1E.W.M.

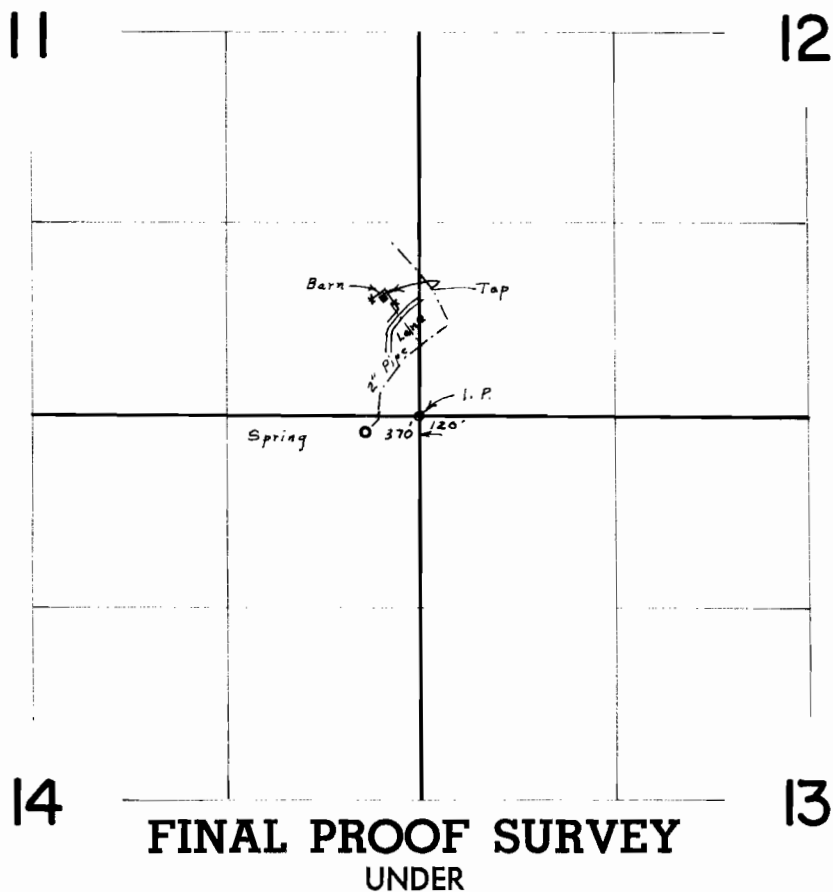

Application No. 39390 Permit No. 29358
IN NAME OF
ORMAN O. & MARTHA E. GILDOW

Surveyed Nov. 17, 1967, by L. E. Gould