


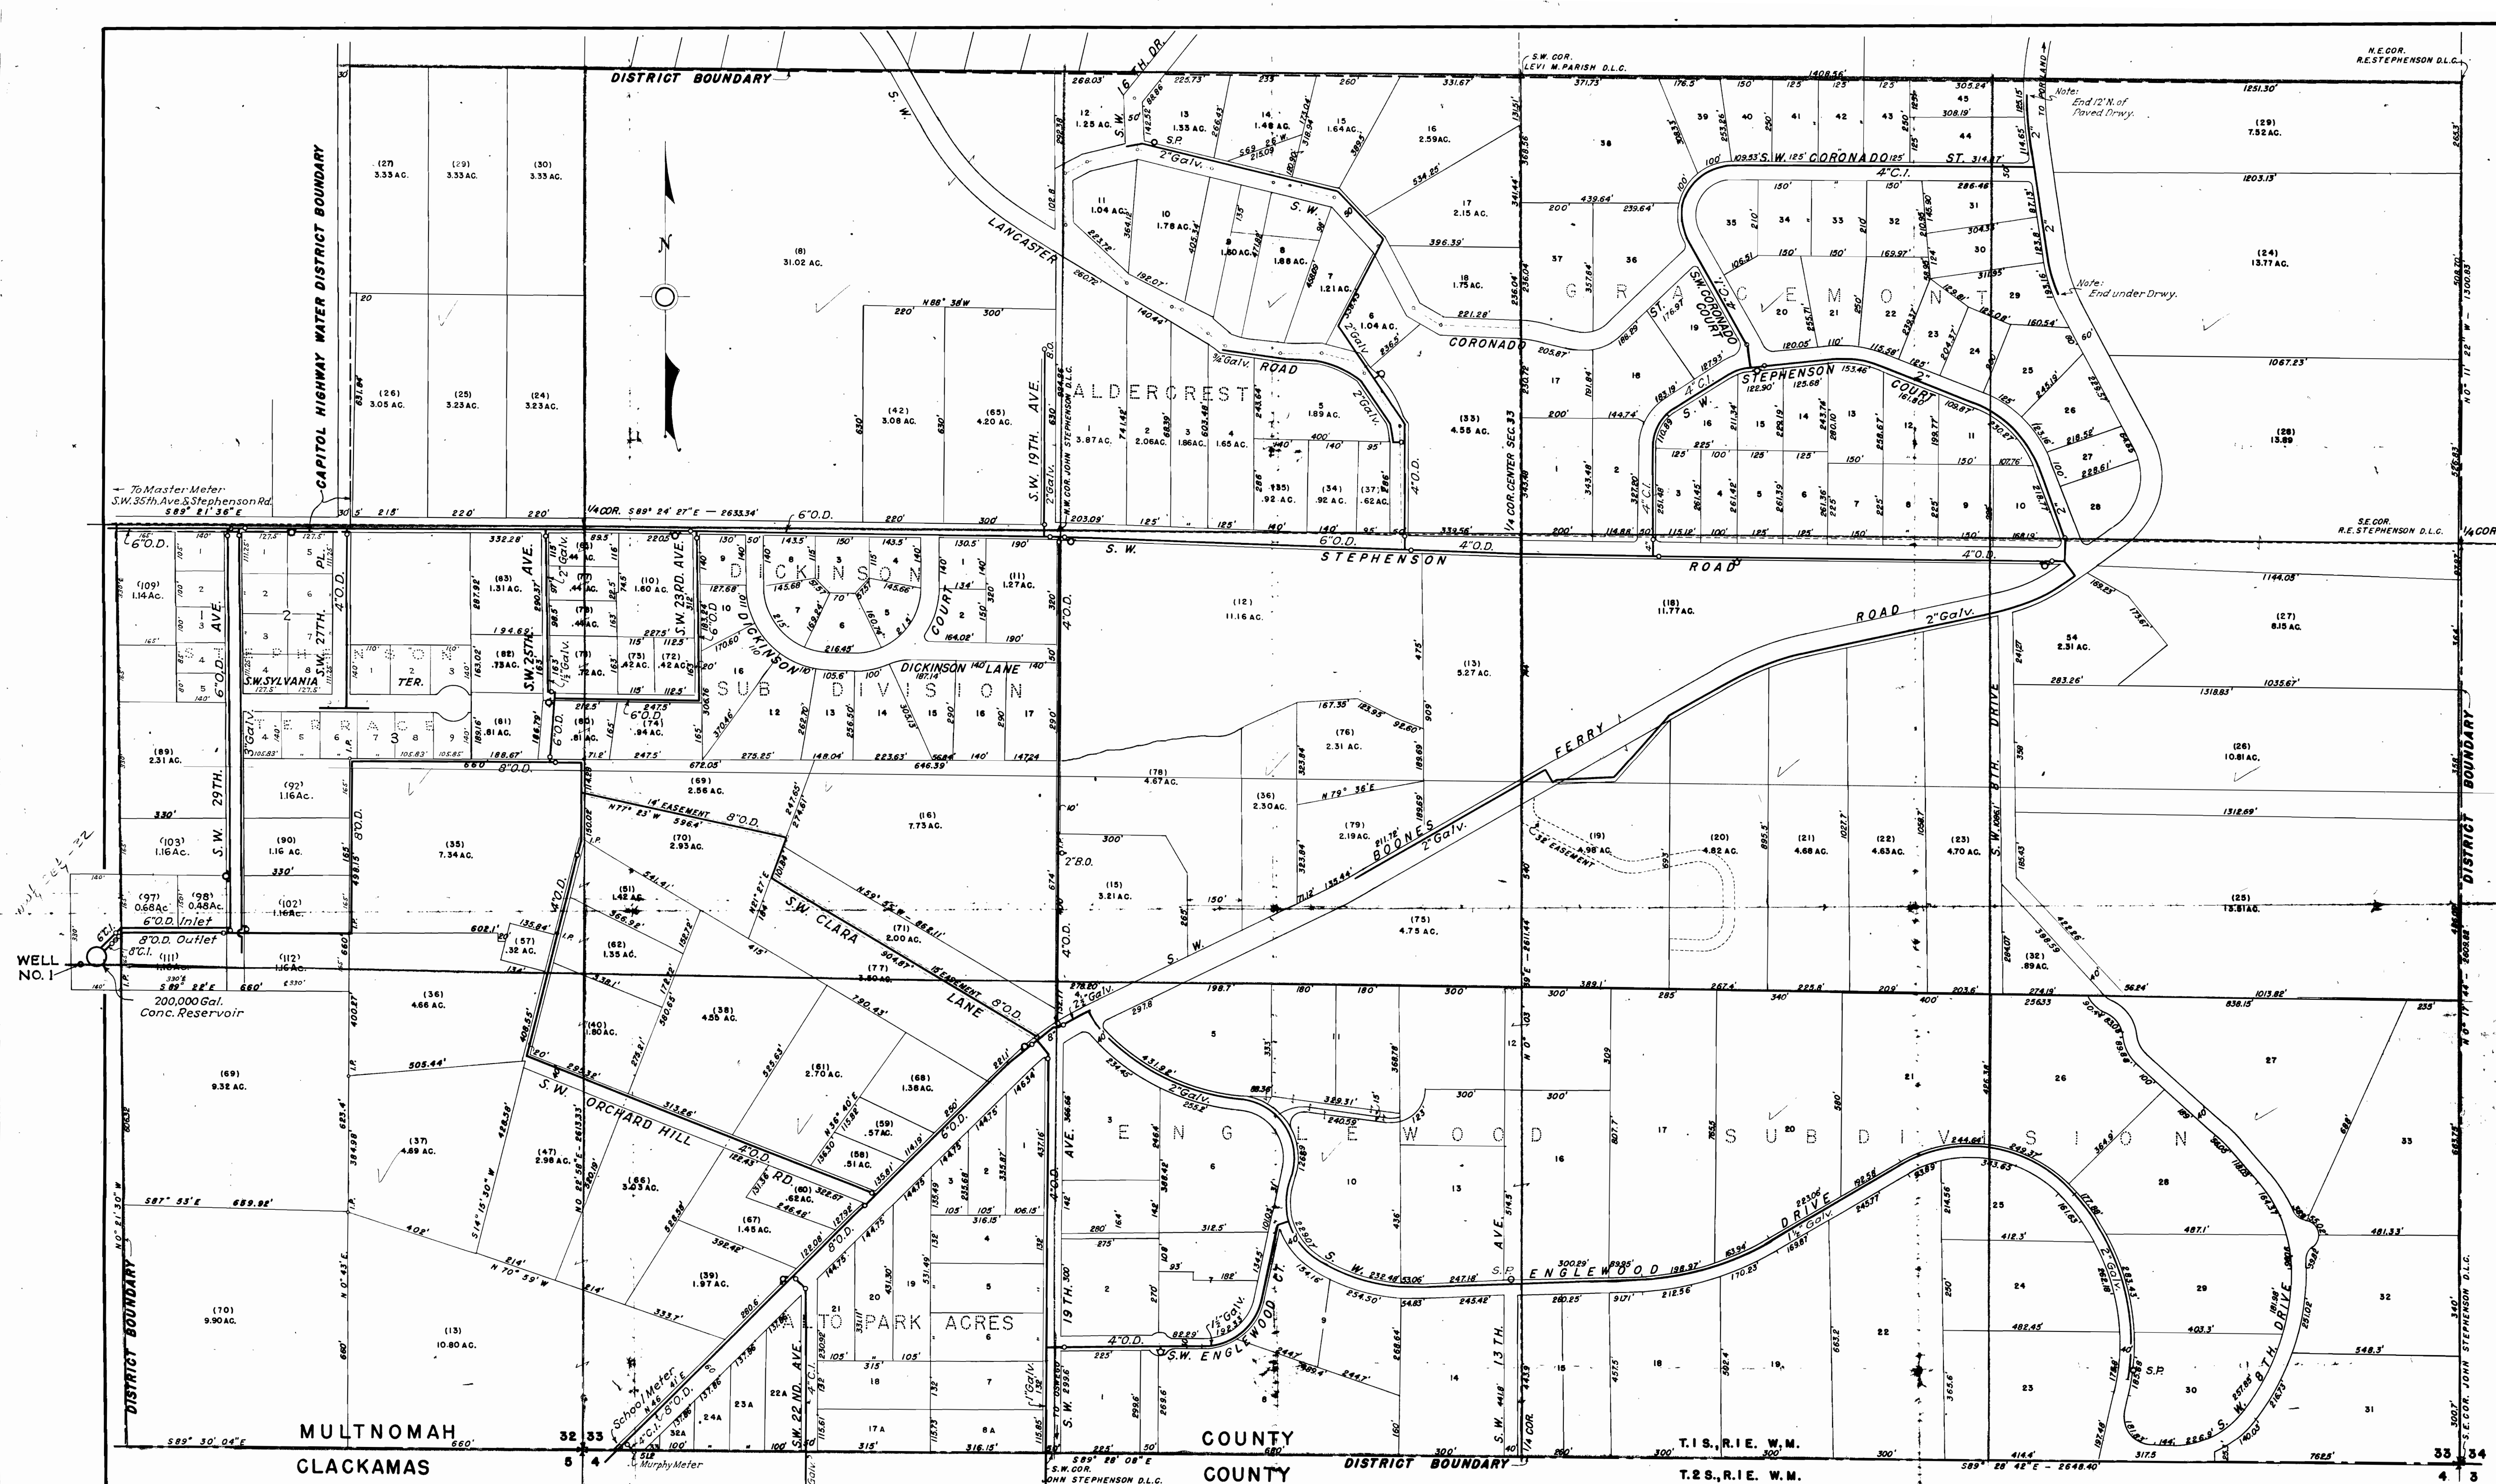

ALTO PARK WATER DISTRICT
WATER DISTRIBUTION SYSTEM

NOV. 1946
Elden W. Carter
C.E. & S. ENGINEER
PORTLAND, ORE.

Application No. G-2219
Permit No. G-2043

Revised
Jan. 1951
Apr. 1953
Jun. 1954
Feb. 1955
Feb. 1957
Dec. 1957
Oct. 1959
Oct. 1960