


T.3N.R.29E.W.M.

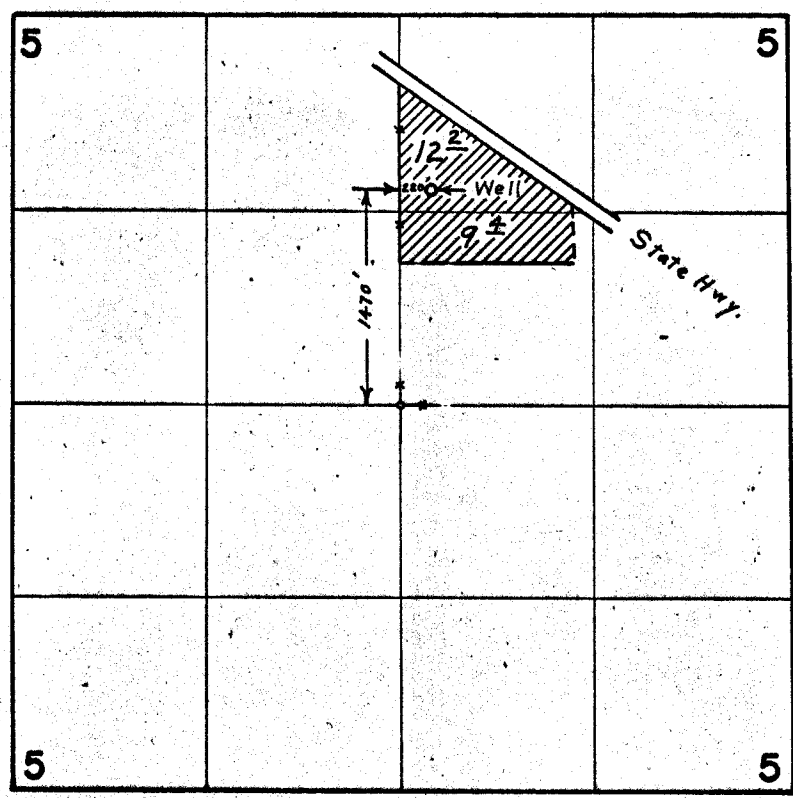

FINAL PROOF SURVEY UNDER

Application No. G-2696 Permit No. G-2501
IN NAME OF
CHARLES E. HERRICK

Surveyed June 28, 1967, by L. E. Gould