


6-2712

51946

35681

T.5N.R.29E.W.M.

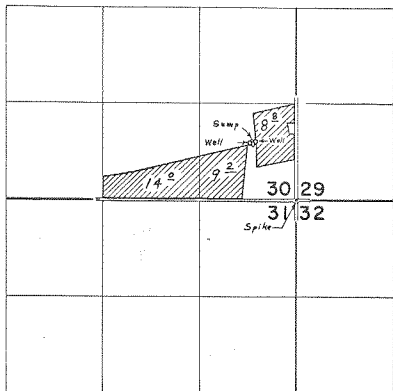

Wells located; 800' N. & 550' W., 780' N. & 663' W. both From S.E. Cor. S.30

FINAL PROOF SURVEY
UNDER

Application No. G-2919 Permit No. G-2712

IN NAME OF

BYRON N. HALLSurveyed JAN. 23, 1967. by L. E. Gould

1967-U