


T. 15. R. 38 E. W. M.

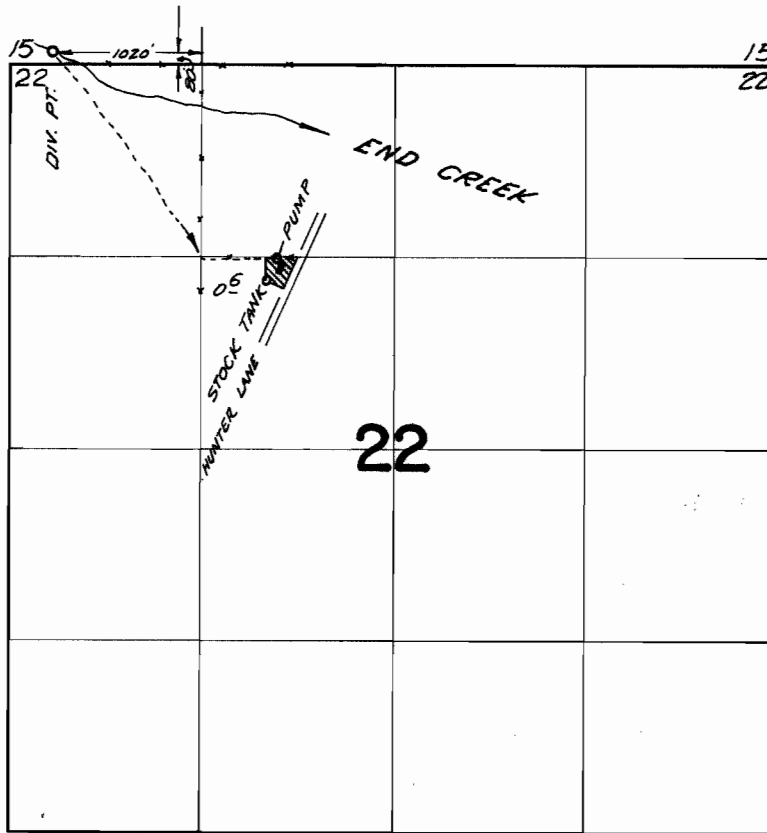

FINAL PROOF SURVEY UNDER

Application No. 38512 Permit No. 28717
IN NAME OF

RUDOLPH MICHEL

Surveyed Aug. 22 19.68, by V. Garner