


T. 1 S. R. 3 W. W. M.

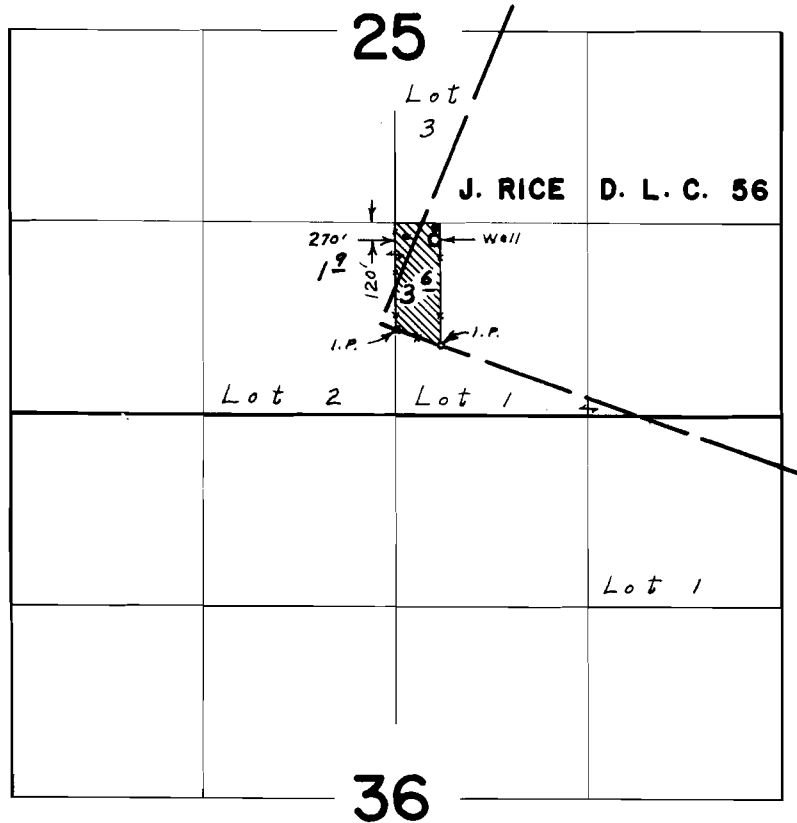

FINAL PROOF SURVEY UNDER

Application No. G-2858 Permit No. G-2659
IN NAME OF

CHARLES W. HUTCHISON

Surveyed Sept. 13, 1967. by L. E. Gould