



EUGENE CONCRETE AND PIPE COMPANY

EUGENE, OREGON

Application No. G-3517
G-3309

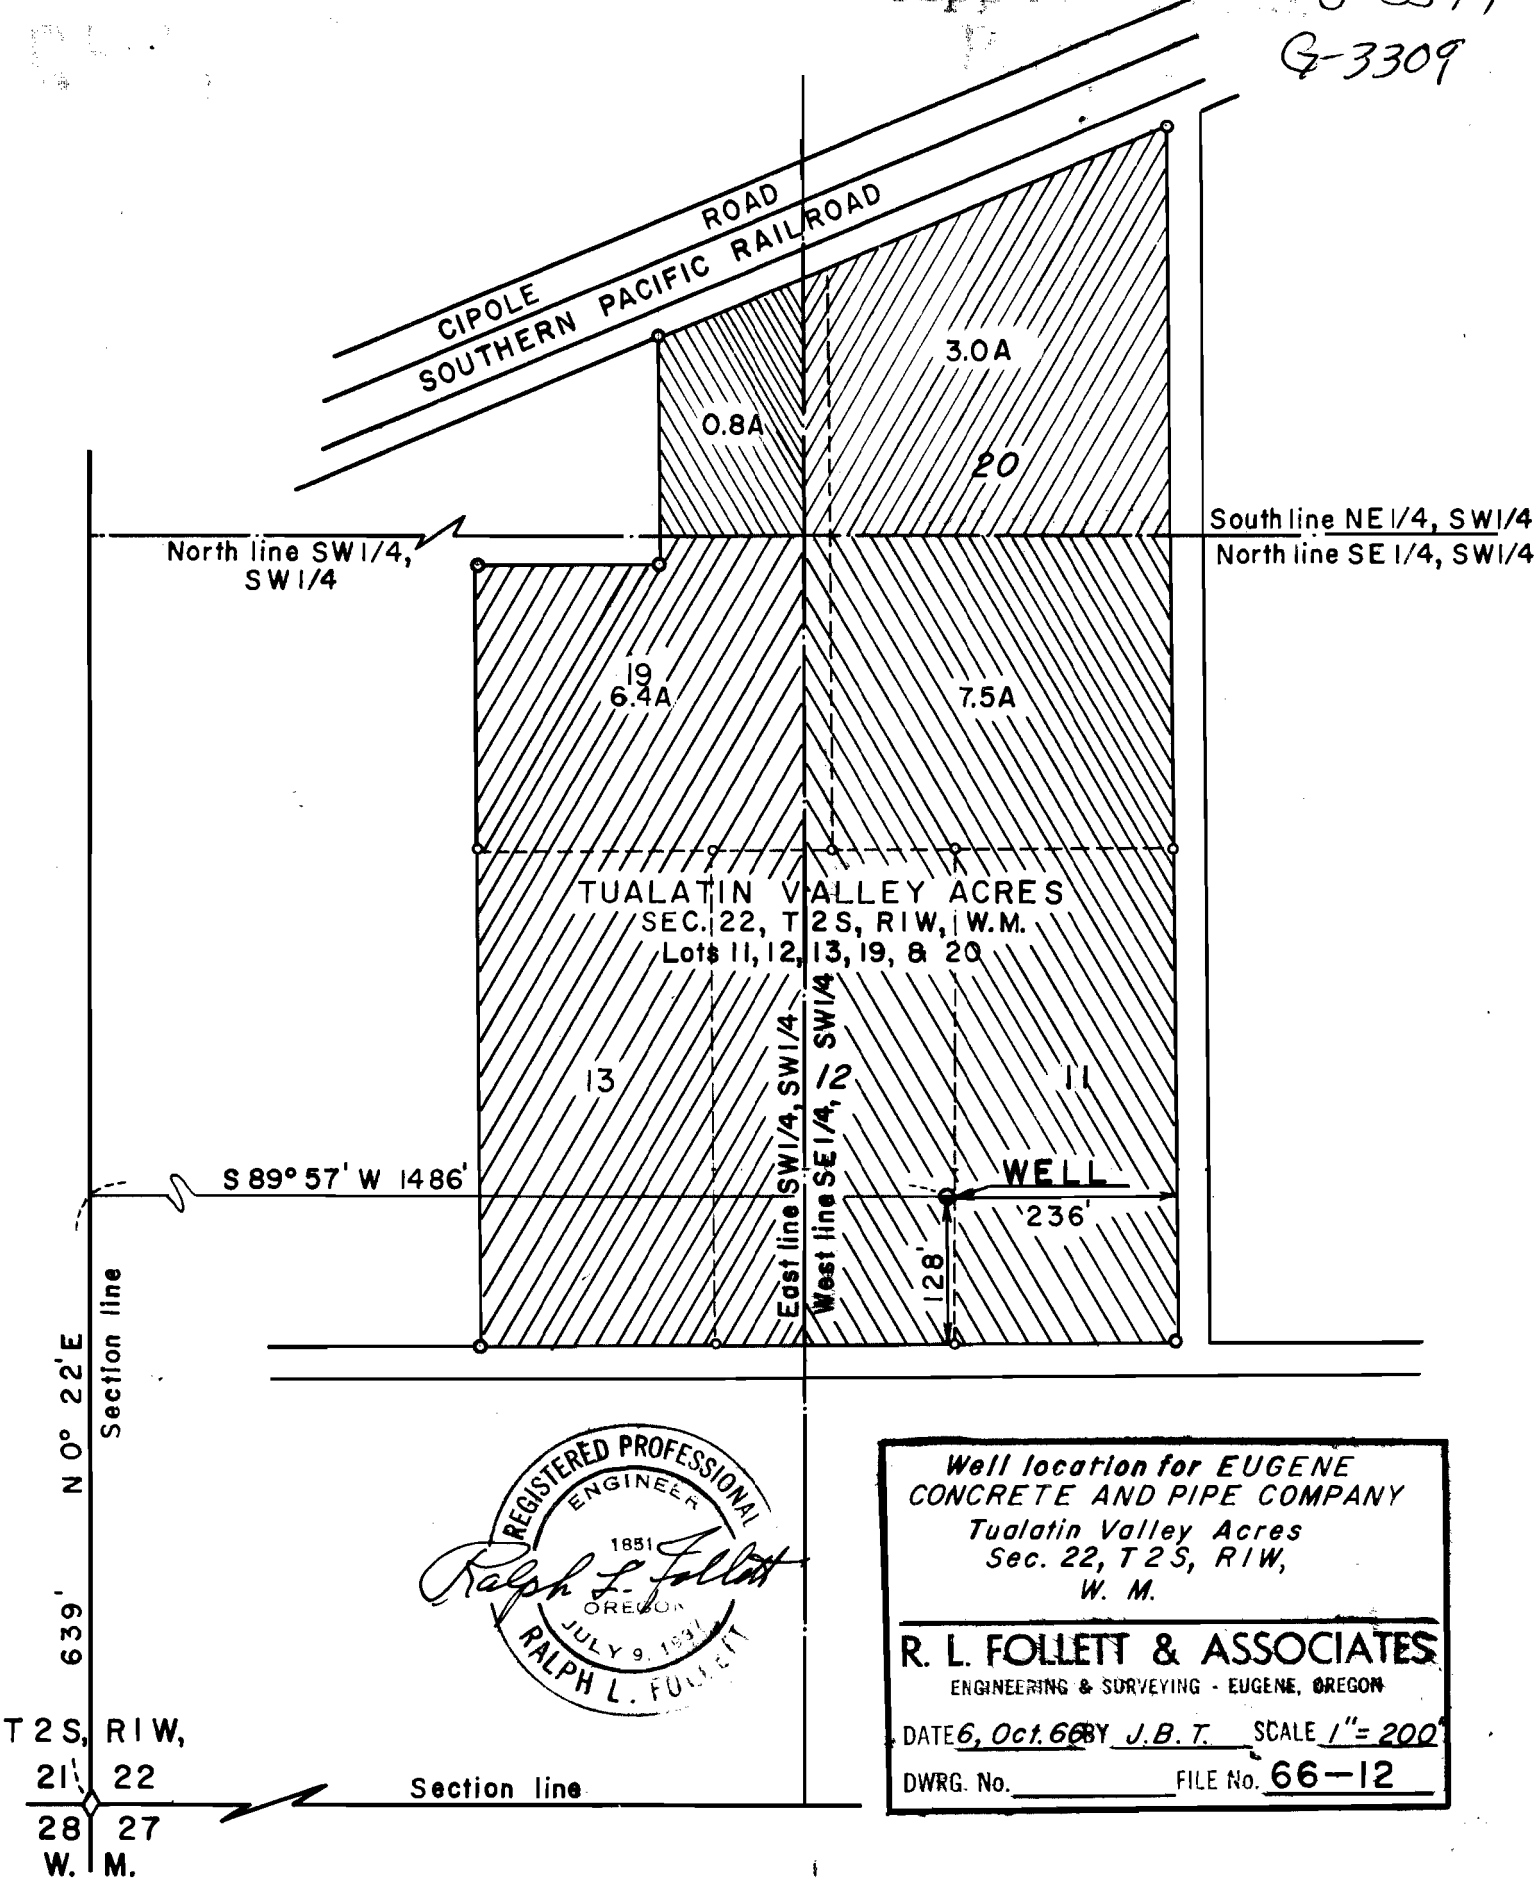

Section line
 N 0° 22' E
 639'
 T 2 S, R 1 W,
 21 22
 28 27
 W. M.

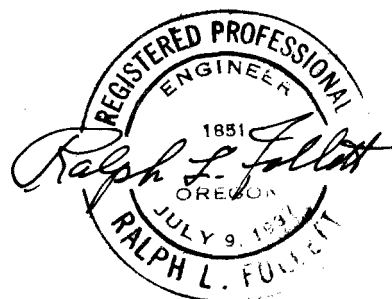

Well location for EUGENE
 CONCRETE AND PIPE COMPANY
 Tualatin Valley Acres
 Sec. 22, T 2 S, R 1 W,
 W. M.

R. L. FOLLETT & ASSOCIATES
 ENGINEERING & SURVEYING - EUGENE, OREGON

DATE 6, Oct. 66 BY J. B. T. SCALE 1" = 200'

DWRG. No. _____ FILE No. 66-12