


# T.1 N.R.3 W.W.M.

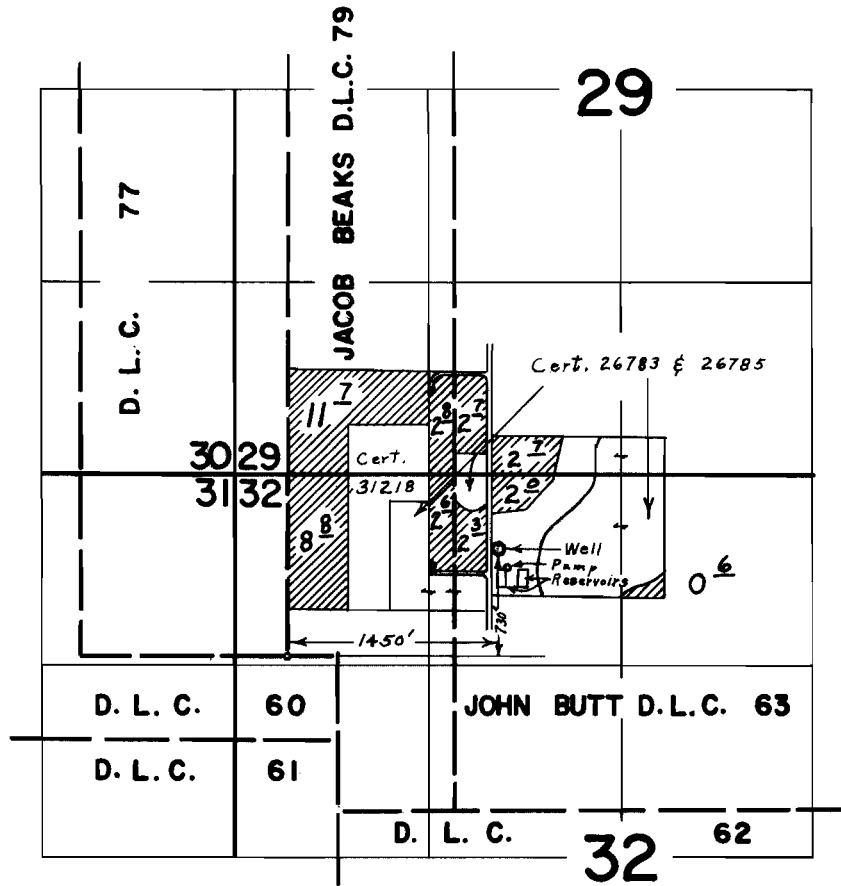

## FINAL PROOF SURVEY UNDER

Application No. G-3603 Permit No. G-3390  
IN NAME OF

EDWARD C. & DOROTHY PORTER

Surveyed Sept. 14, 1967., by L. E. Gould